


MICROFILMED



14

12

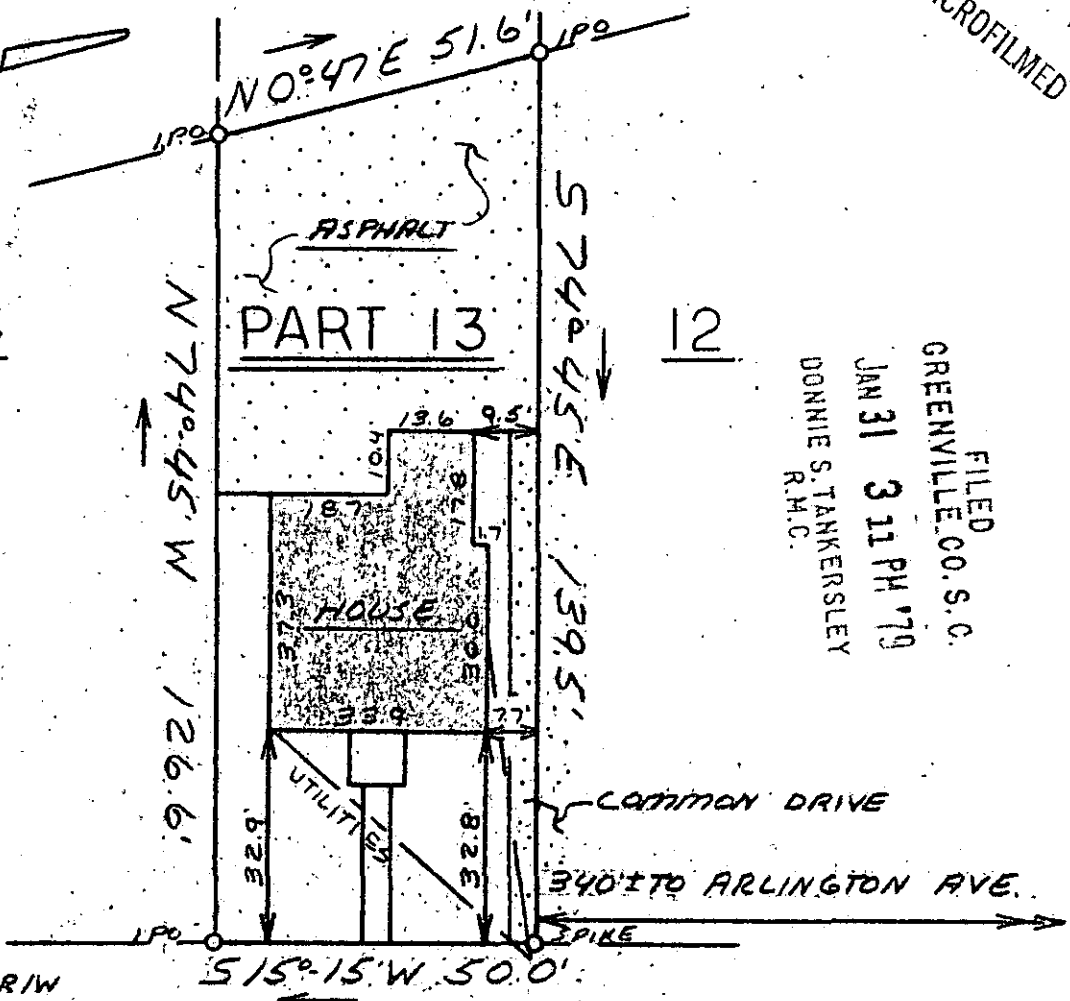

FILED
 GREENVILLE CO. S.C.
 JAN 31 3 11 PM '79
 DONNIE S. TANKERSLEY
 R.M.C.

WATER & SEWER IN ST. RIW

SUMNER STREET

This is to certify that on January 23, 1979, I surveyed the property shown on this plat, known as Part Lot 13 on Plat of Pendleton Street Realty Associates Property, Block B, recorded in the RMC Office of Greenville County in Plat Book A on Pages 122 & 123, and that the property lines, walls and buildings are as shown hereon; that the building located on said lot does not encroach or project on adjacent streets or property, and that no adjacent walls or buildings encroach or project on said premises, and that no utility lines cross this property except as shown hereon. This property is not located in a designated flood hazard area.

JAN 31 1979

22395

James R. Freeland
 James R. Freeland RLS & FE 4781

77-4-6 ✓ 6Z-41



**STATE OF SOUTH CAROLINA
 GREENVILLE COUNTY**

PROPERTY OF

LEROY C. JONES JR.

GLENDA L. JONES

FREELAND & ASSOCIATES
 Engineers • Land Surveyors

GREENVILLE, S. C.

SURVEY *R.P.*

DRAWN *M.C.*

CHECK *RKP*

SCALE 1" = 30'

DATE 1-23-79

DWO. NO. 79-2833

SEAL