


MICROFILMED

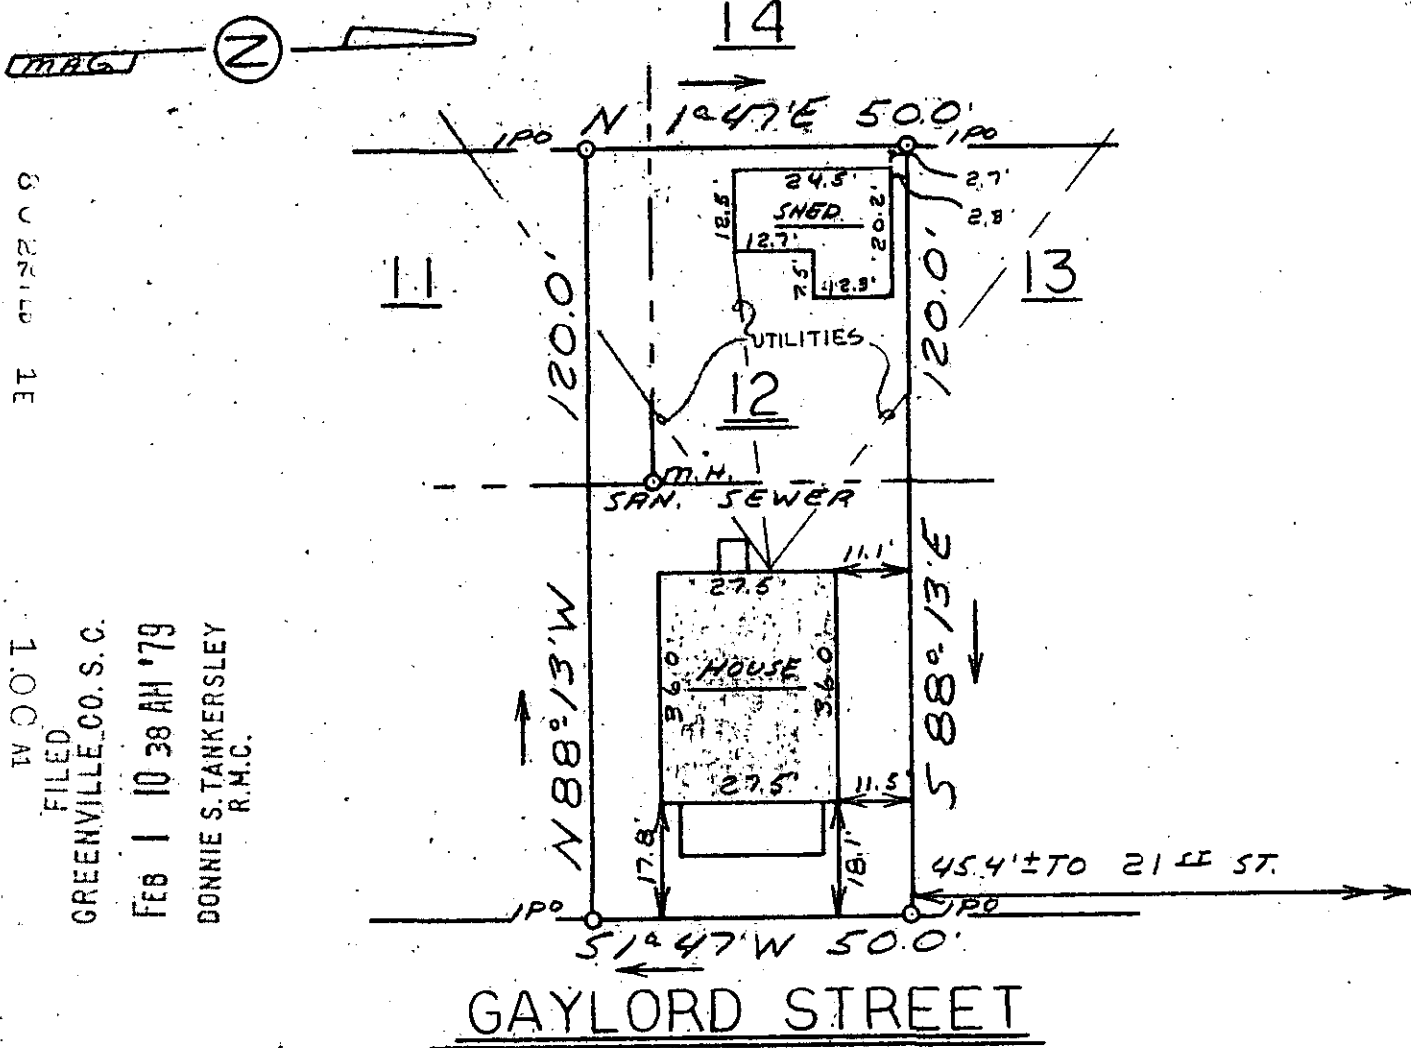

W O O L 1.00 AM
 FILED
 GREENVILLE, CO. S. C.
 FEB 1 10 38 AM '79
 BONNIE S. TANKERSLEY
 R.M.C.

GAYLORD STREET

This is to certify that on January 29, 1979, I surveyed the property shown on this plat, known as Lot 12 on Plat of Judson Mills No. 2 Village, Block G, recorded in the RMC Office of Greenville County in Plat Book K on Pages 1 & 2, and that the property lines, walls and buildings are as shown hereon; that the building located on said lot does not encroach or project on adjacent streets or property, and that no adjacent walls or buildings encroach or project on said premises, and that no utility lines cross this property except as shown hereon. This property is not located in a designated flood hazard area.

James R. Freeland
 James K. Freeland RLS & PE 4781

V6-2-43 22527

116-4-7

FEB 1 1979



SEAL

**STATE OF SOUTH CAROLINA
 GREENVILLE COUNTY**
JUDSON MILLS NO. 2
BLOCK G - LOT 12
 PROPERTY OF
DANNY R FAULKNER &
LYNETTE M. FAULKNER

FREELAND & ASSOCIATES
 Engineers • Land Surveyors
 GREENVILLE, S. C.

SURVEY	RP
DRAWN	ML
CHECK	FKP
SCALE	1" = 30'
DATE	1-29-79
DWG. NO.	79-2855