

MICROFILMED

FILED
GREENVILLE CO. S. C.
FEB 1 '79 10 PH '79
DONNIE S. TANKERSLEY
R.M.C.

TOWNES STREET

No 9-45E
89.88'



BRICK

GARAGE

GRAVEL DRIVE

BUIST AVENUE

N 80-21 W 20.25'

S 80-14 E 199.02'

Lot No. 4 -

Lot No. 3 -

22611

FEB 1 1979

ALLEY

THIS LOT IS NOT
LOCATED IN A FLOOD
DISASTER AREA.

THIS IS TO CERTIFY THAT ON THE DATE SHOWN HEREON, I DID SURVEY THE ABOVE
PROPERTY. THE SAME BEING KNOWN AND DESIGNATED AS Lot No. 4, of Block "C" of
BUIST CIRCLE. AS SHOWN BY A PLAT RECORDED IN THE CLERK OF COURTS
OFFICE FOR GREENVILLE COUNTY IN PLAT BOOK C AT PAGE 10. I
FURTHER CERTIFY THAT THE PROPERTY LINES, STREETS, AND BUILDINGS ARE AS SHOWN
ABOVE AND THAT THERE ARE NO ENCROACHMENTS EXCEPT AS SHOWN.

JAN. 24, 1979
DATE

✓ 6Z-45

Robert R. Spearman
ROBERT R. SPEARMAN REG. L. S. NO. 3615

TITLE
SURVEY FOR


DENNIS D. MOORE
MARTHA F. MOORE

LOCATED AT 42 BUIST AVENUE
IN THE CITY OF GREENVILLE


LEGEND

- _____ IRON PIN (OLD)
- _____ IRON PIN (NEW)
- △ _____ NAIL & CAP
- _____ AS NOTED

GRAPHIC SCALE

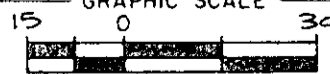

SEAL

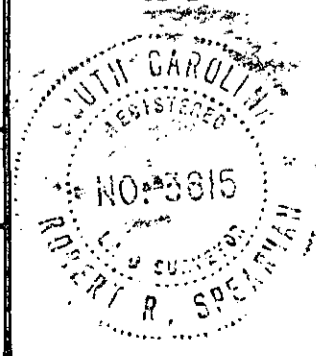

STATE
SOUTH CAROLINA

COUNTY
GREENVILLE

SCALE
1" = 30'

DATE
JAN. 24, 1979

REF. NO.

ROBERT R. SPEARMAN
Registered Surveyor 3615
Post Office Box 6
Eastley, South Carolina 29640



GC10
3 EE 1 79
230