FILED
GREENVILLE CO. S.C.
FEB 14 12 27 PM '79
DONNIE S. TANKERSLEY
R.M.C.

MICROFILMED

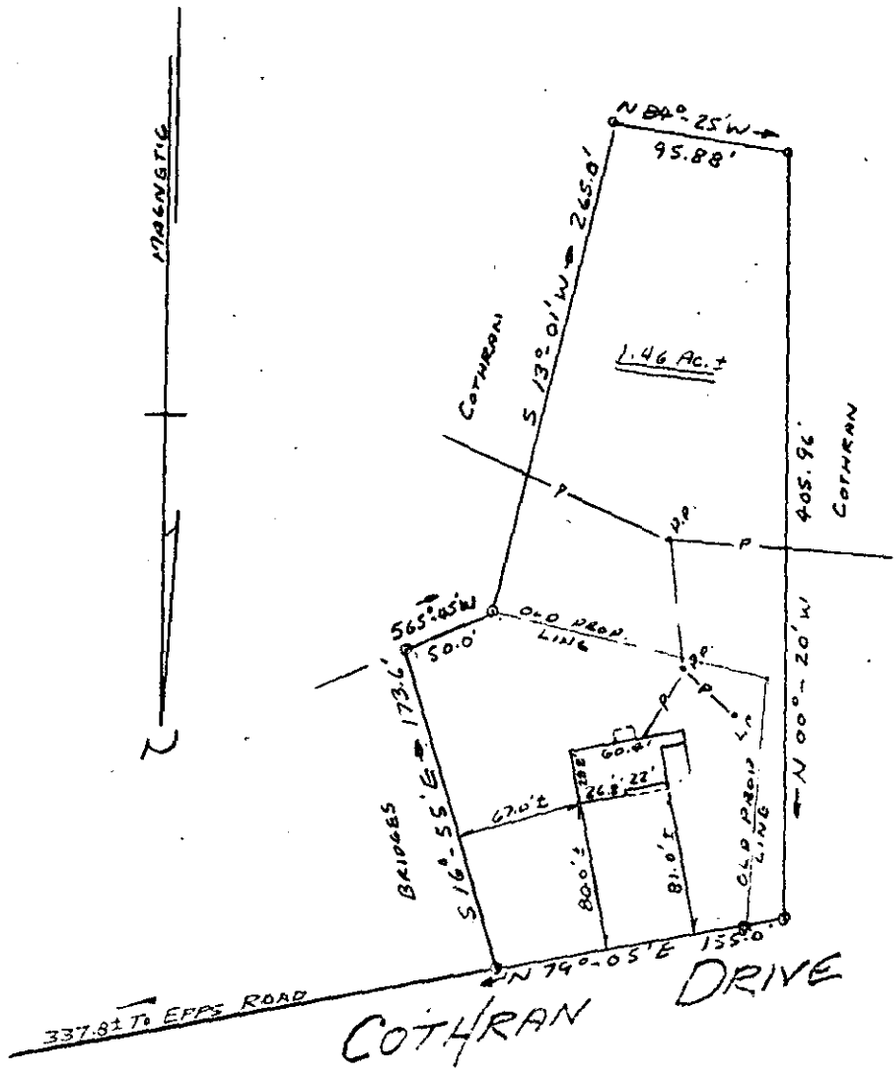

23636

PROPERTY OF
JACK M. RIDDLE &
WANDA G. RIDDLE
NEAR GREENVILLE, SOUTH CAR.
JAN. 29, 1979 SCALE: 1" = 100'

FEB 14 1979

V 6-Z-85

This is to certify that on January 29, 1979, I surveyed the property shown on this plat, known as Property of Jack M. Riddle and Wanda G. Riddle as shown on a plat recorded in the RMC Office for Greenville County, in Plat Book 6-Z, page 85, and that the property lines, walls and buildings are as shown hereon, and that the building located on said lot does not project nor encroach on adjacent streets or property, and that no adjacent walls or buildings project nor encroach on said property, and that no utility lines cross this lot except as may be shown hereon.

NOTE: This property is not located within a flood hazard area.

Survey by: Century Land Surveying Co.
Greenville, South Carolina

S. C. R. L. S. No. 4678

GCTO ----- FE14 79 1243
1.00CI