


FILED
GREENVILLE CO. S. C.
FEB 14 4 47 PM '79

RONNIE S. TANKERSLEY
R.M.C.

This is to certify that on January 31, 1970, I surveyed the property shown on this plat, known as Lot 5 on Plat of W.T. Patrick & Wm. R. Timmons Jr. Property, recorded in the RMC Office of Greenville County in Plat Book EE on Page 157 and that the property lines, walls and buildings are as shown hereon; that the building located on said lot does not encroach or project on adjacent streets or property, and that no adjacent walls or buildings encroach or project on said premises, and that no utility lines cross this property except as shown hereon. This property is not located in a designated flood hazard area.

James R. Freeland
James R. Freeland RLS & PE 4781

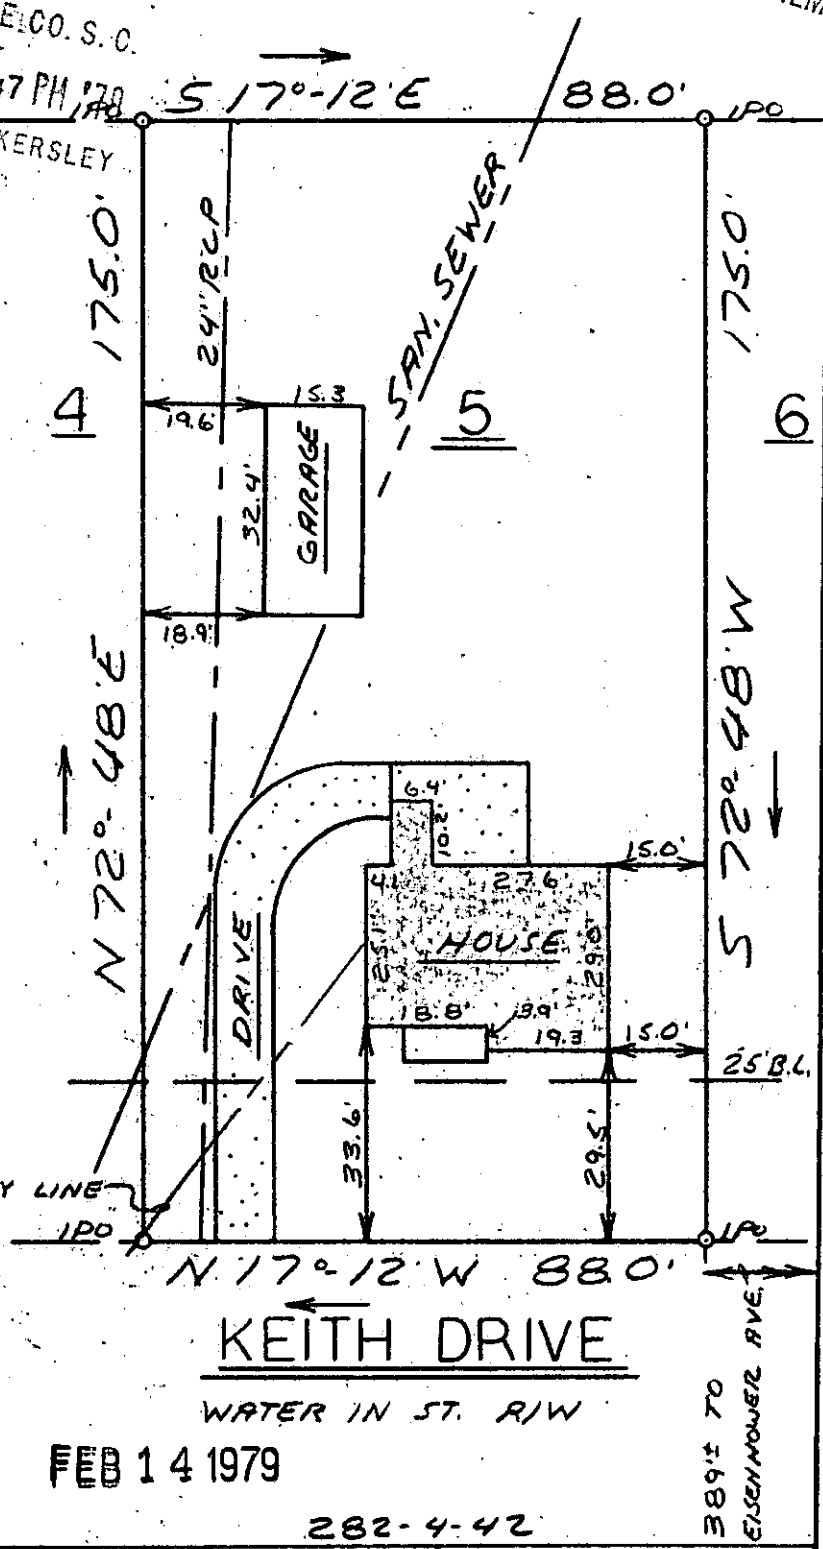

GCTO --- 1 FEB 14 79 1 579

23663

KEITH DRIVE

WATER IN ST. R/W

✓ 6-Z.87

FEB 14 1979

282-4-42

389± TO
EISENHOWER AVE.



**STATE OF SOUTH CAROLINA
GREENVILLE COUNTY**
W.T. PATRICK & WM. R. TIMMONS
JR. PROPERTY
LOT 5
PROPERTY OF
BERNARD EDRIS MILLER JR.
JANET S. MILLER

FREELAND & ASSOCIATES
Engineers • Land Surveyors
GREENVILLE, S. C.
SURVEY *RP*
DRAWN *MC*
CHECK *WDR*
SCALE 1" = 30'
DATE 1-31-79
DWO. NO. 79-2864