


This is to certify that on May 23, 1979, I surveyed the property shown on this plat, known as Property of Jack A. Burgess Jr. and Maria Julia Andraud Burgess, recorded in the RMC Office of Greenville County in Deed Book 975 on Page 385, and that the property lines, walls and buildings are as shown hereon; that the building located on said lot does not encroach or project on adjacent streets or property, and that no adjacent walls or buildings encroach or project on said premises; and that no utility lines cross this property except as shown hereon. This property is not located in a designated flood hazard area.

James R. Freeland
 James R. Freeland RLS & PE 4781

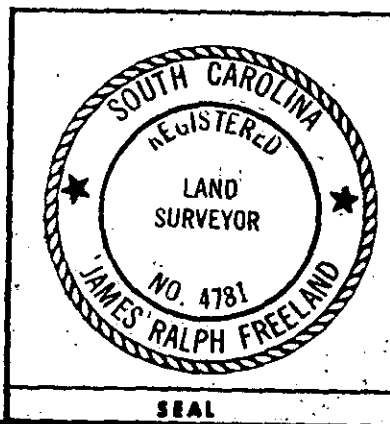

**STATE OF SOUTH CAROLINA
 GREENVILLE COUNTY**

PROPERTY OF
**MARVIN N. CALDWELL
 MARGARET C. CALDWELL**

FREELAND & ASSOCIATES Engineers • Land Surveyors GREENVILLE, S. C.	
SURVEY	DH
DRAWN	JRF
CHECK	M.C.
SCALE	1"=100'
DATE	5-23-79
DWG. NO.	79-3377

MICROFILMED