


MICROFILMED

FILED
GREENVILLE CO. S.C.
FEB 28 2 53 PM '79
DANNIE S. TANKERSLEY
R.M.C.

FEB 28 1979

Note: There is a drainage and utilities easement 5' each side of all side and rear lot lines.

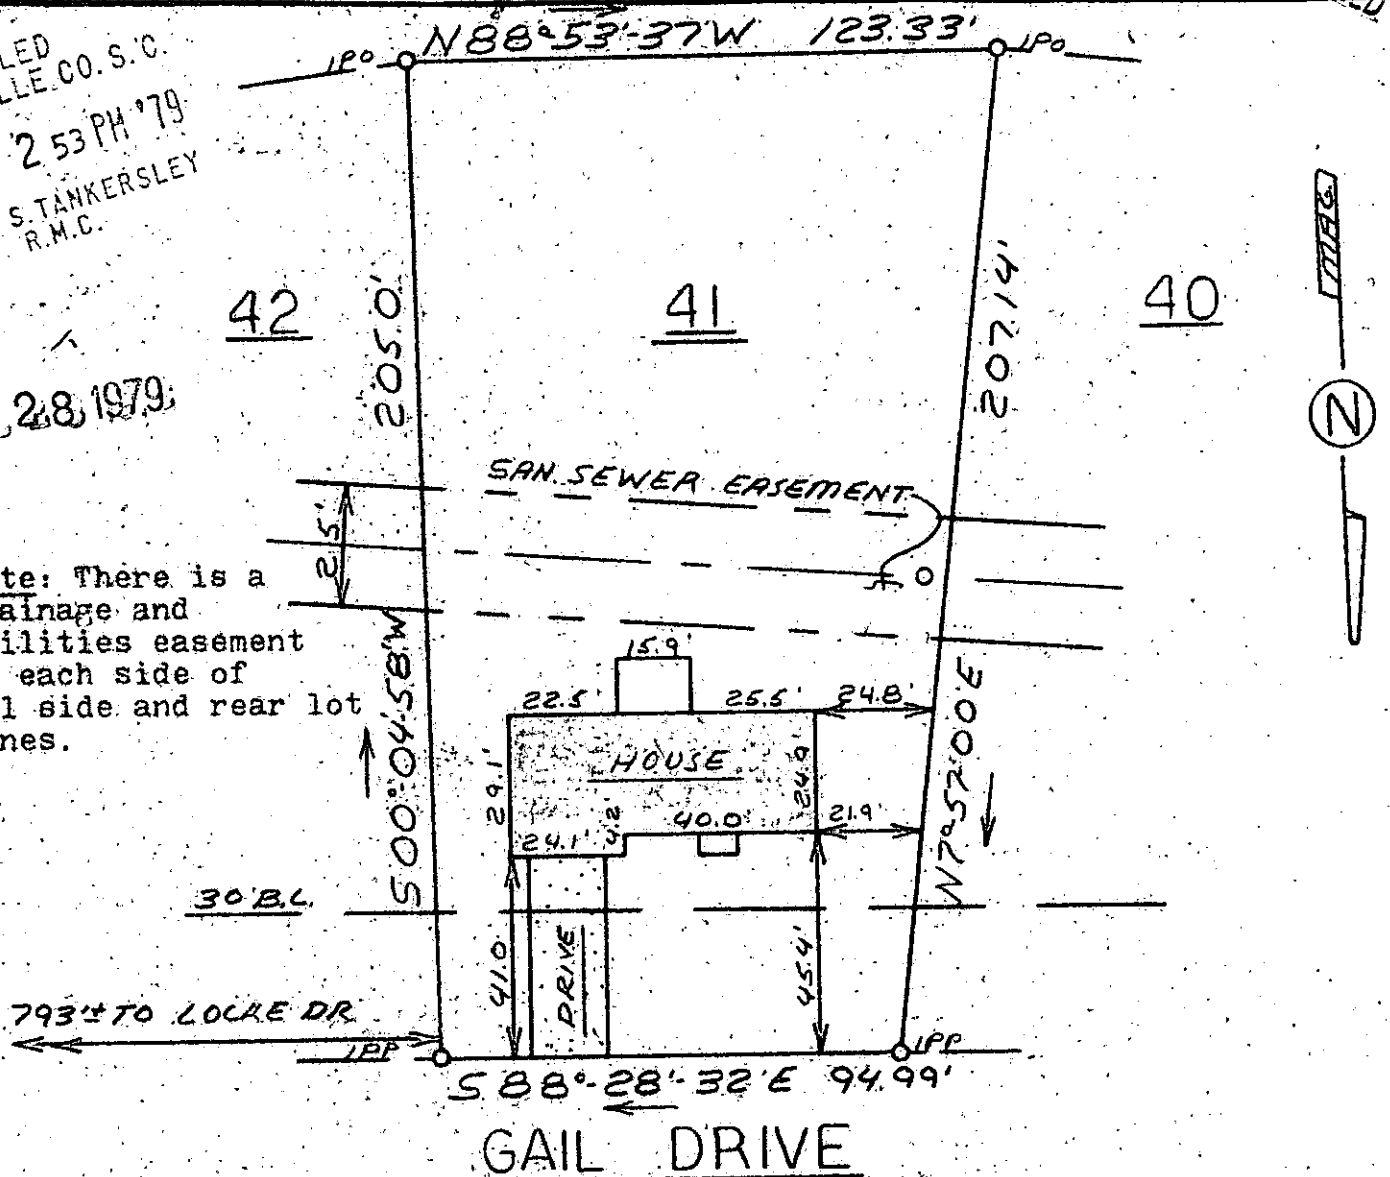

This is to certify that on February 22, 1979, I surveyed the property shown on this plat known as Lot 41 on Plat of Knollwood Heights Section 5, recorded in the RMC Office of Greenville County in Plat Book 4R on Page 91, and that the property lines, walls, and buildings are as shown hereon; that the building located on said lot does not encroach or project on adjacent streets or property, and that no adjacent walls or buildings encroach or project on said premises, and that no utility lines cross this property except as shown hereon. This property is not located in a designated flood hazard area.

✓ 17-B-12 24861 *James R. Freeland*
James R. Freeland RLS. & PE 4781



STATE OF SOUTH CAROLINA
GREENVILLE COUNTY
KNOLLWOOD HEIGHTS
SEC. 5 - LOT 41
PROPERTY OF
JAMES T. CRAIG JR. &
JEAN T. CRAIG

FREELAND & ASSOCIATES
Engineers • Land Surveyors
GREENVILLE, S. C.
SURVEY *RP*
DRAWN *ML*
CHECK *JRF*
SCALE *1" = 40'*
DATE *2-22-79*
DWO. NO. *79-293A*

GC10 2 FEB 28 79 807 1.0CCI