

MICROFILMED


MAG NORTH

NOTE: ALL LOT NO'S ARE TAX BLK. BK. NO'S

This is to certify that on March 12, 1979, I surveyed the property shown on this plat known as Lot 25 on Block Book 21-1-25, and recorded in the RMC Office of Greenville County in Deed Book 92 on Page 566, and that the property lines, walls, and buildings are as shown hereon; that the building located on said lot does not encroach or project on adjacent streets or property, and that no adjacent walls or buildings, encroach or project on said premises, and that no utility lines cross this property except as shown hereon. This property is not located in a designated flood hazard area.

James R. Freeland
James R. Freeland RLS & FS 4781

FILED
GREENVILLE CO. S.C.
MAR 14 9 52 AM '79
DORRIS S. TANKERSLEY
R.M.C.

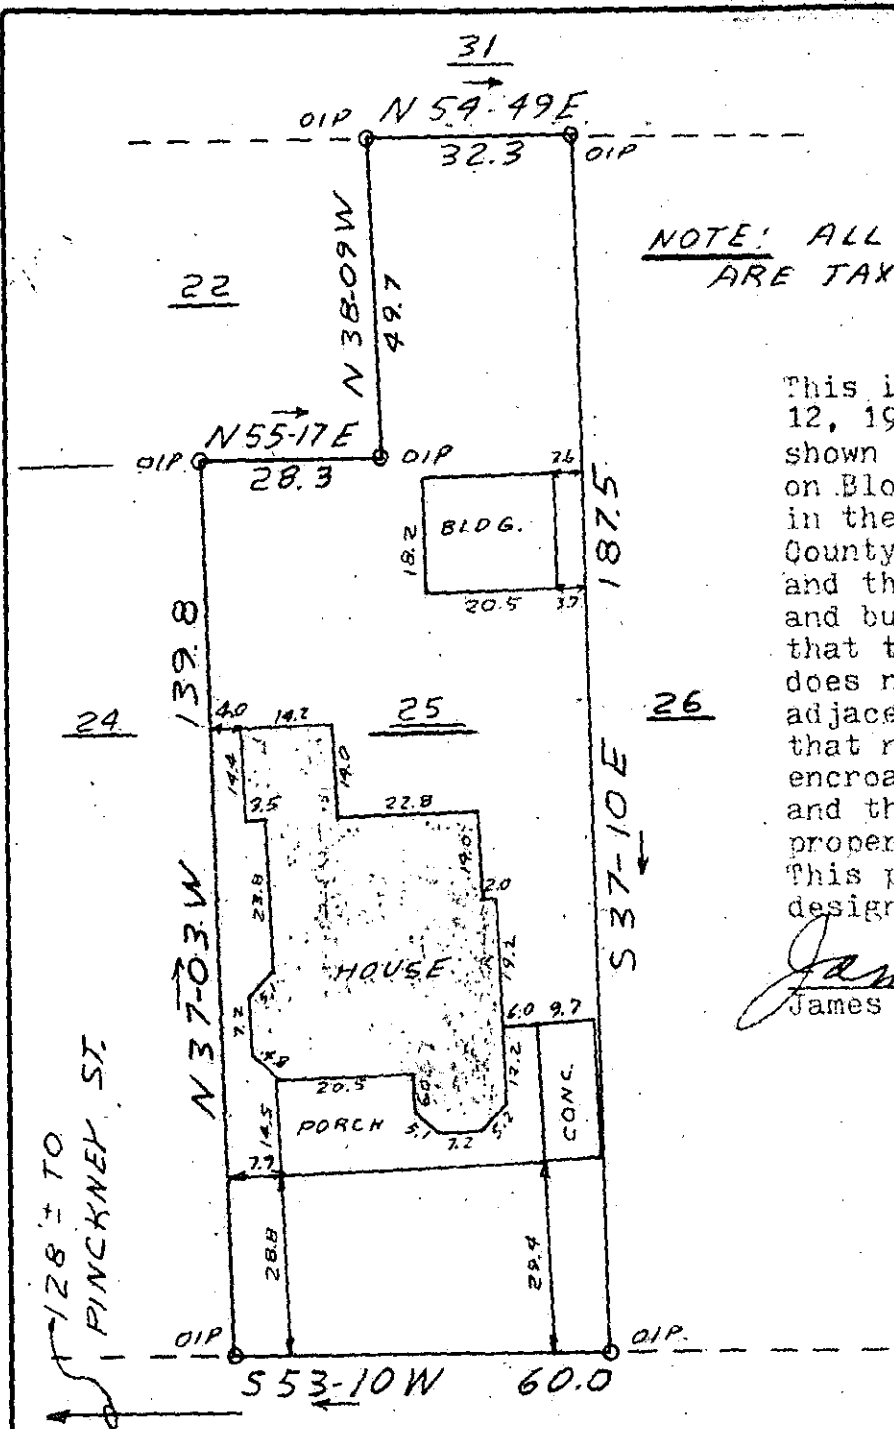

LLOYD STREET

26195

(WATER & SEWER IN ST R/W)

21-1-25

MAR 14 1979

7-B-54



SEAL

STATE OF SOUTH CAROLINA
GREENVILLE COUNTY

PROPERTY OF

WILLIAM ANTHONY JOHNSON

FREELAND & ASSOCIATES
Engineers • Land Surveyors

GREENVILLE, S. C.

SURVEY R.P.
DRAWN J.R.T.
CHECK M.C.
SCALE 1" = 30'
DATE 3-12-79
DWD. NO. 78-2713

10001
1470-1512