


MICROFILMED

FILED  
GREENVILLE, CO. S. C.

MAR 14 4.03 PM '79

DONNIE S. TANKERSLEY  
R.M.C.

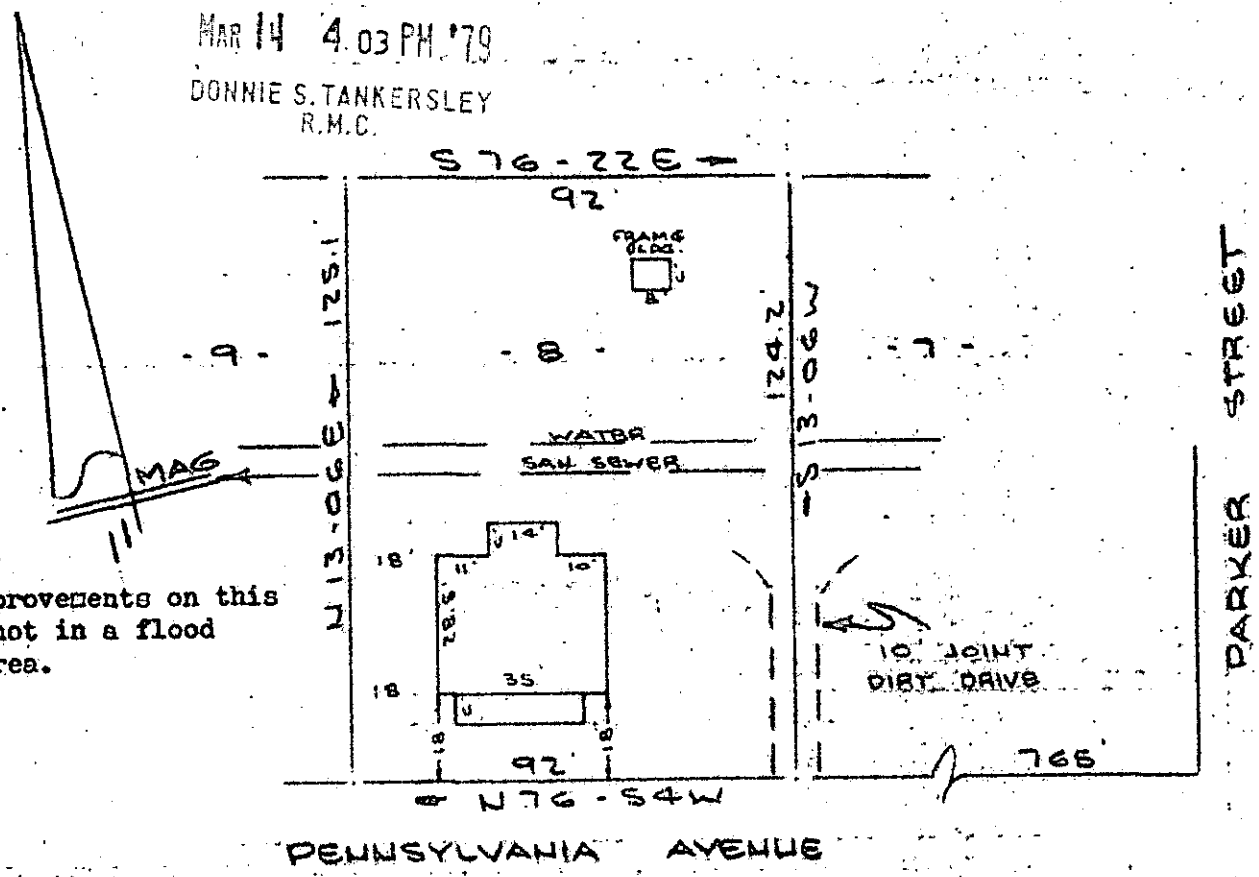

PROPERTY OF  
**WILSON L. ELLENBURG & ELLOUISE B. ELLENBURG**  
 GREER, SOUTH CAROLINA  
 SCALE: 1" = 40' 28 MAR 1979

This is to certify that on the 8th day of March, 1979, I surveyed the property shown on this plat, being known as lot 8 on plat of SUBDIVISION OF GREER MILL VILLAGE and recorded in the RMC Office Greenville County, S. C., in Plat Book " Y " at Page 138 & 139; and that the property lines, walls and buildings are as shown hereon, and that the walls and buildings located on said lot do not encroach or project on adjacent street or property, and that no adjacent walls or buildings encroach or project on said premises, and no power lines cross this property except as shown hereon.

MAR 14 1979

✓ 7-B-57

26310

CAROLINA SURVEYING CO.  
 112 Manly St.  
 Greenville, S. C.

*R. B. Bruce*  
 R. B. Bruce, RLS #1952

SOUTH CAROLINA  
 REGISTERED  
 1952  
 SURVEYOR  
 BRUCE