

MICROFILMED

FILED  
GREENVILLE, CO. S. C.


MAR 21 1 29 PM '79

DONNIE S. TANKERSLEY  
R.M.C.

9

8

7

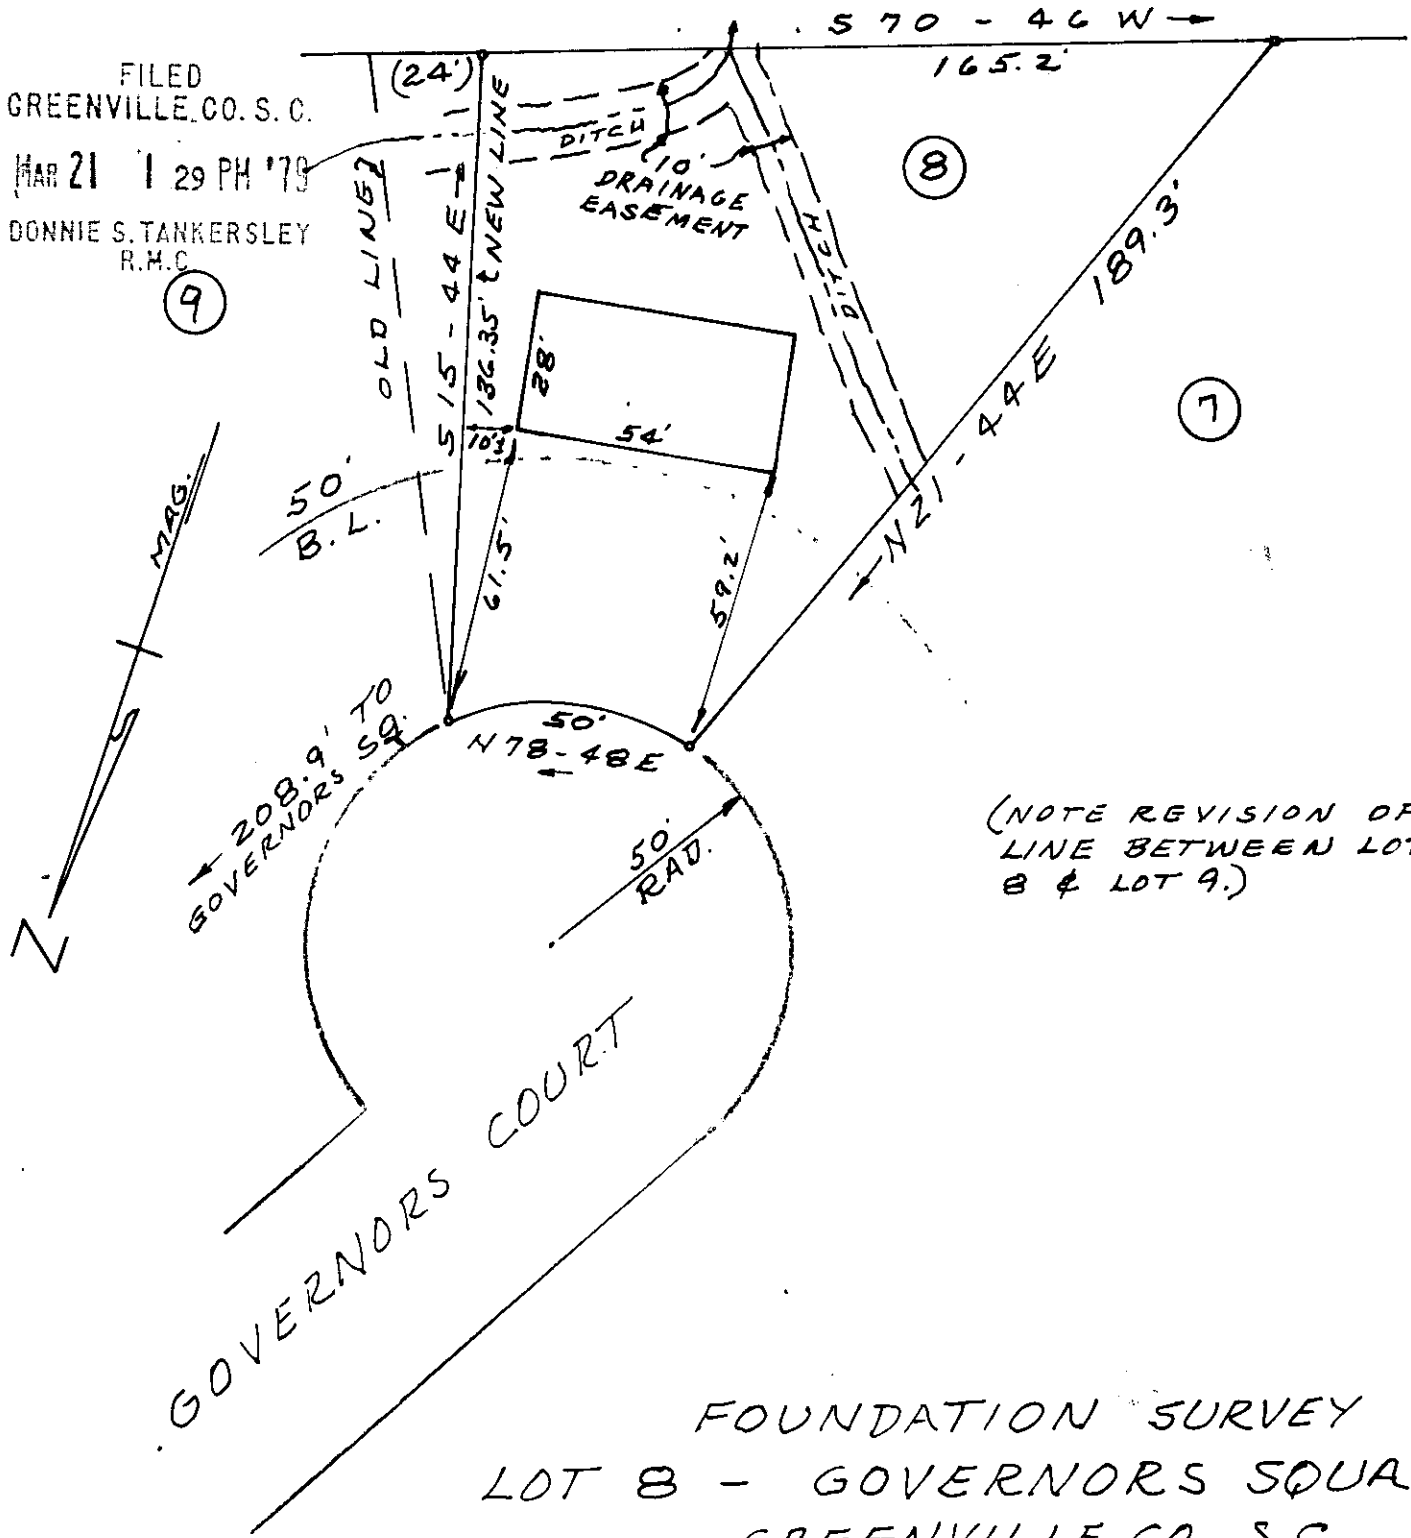

(NOTE REVISION OF  
LINE BETWEEN LOT  
8 & LOT 9.)

FOUNDATION SURVEY  
LOT 8 - GOVERNORS SQUARE  
GREENVILLE CO., S.C.

FEB. 15, 1979


SCALE 1" = 40'

26998

✓ 7-B-75

MAR 21 1979

SURVEY BY: CLARKSON SURVEYING  
H.C. Clarkson, Jr.  
SCRLS N° 2589

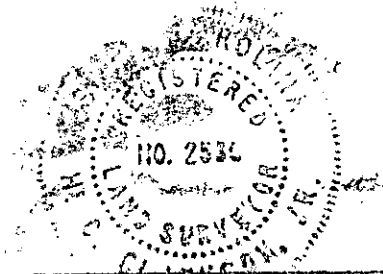

GCTO --- 1 MR21 79 613

1.000CI

N.B. #150