

FILED  
 GREENVILLE CO. S. C.  
 APR 4 4 33 PM '79  
 DONNIE S. TANKERSLEY  
 R.M.C.


624' TO LOWNDES HILL RD.

BRIARCLIFF DRIVE 28737  
 WATER & SEWER IN ST. RI/W

This is to certify that on February 22, 1979, I surveyed the property shown on this plat known as Lot 15 & Part 16 of Dixie Heights recorded in the RMC Office of Greenville County in Plat Book H on Page 46, and that the property lines, walls, and buildings are as shown hereon; that the building located on said lot does not encroach or project on adjacent streets or property, and that no adjacent walls or buildings encroach or project on said premises, and that no utility lines cross this property except as shown hereon. This property is not located in a designated flood hazard area.

*James R. Freeland*  
 James R. Freeland RLS & PE 4781

192-6-16-17

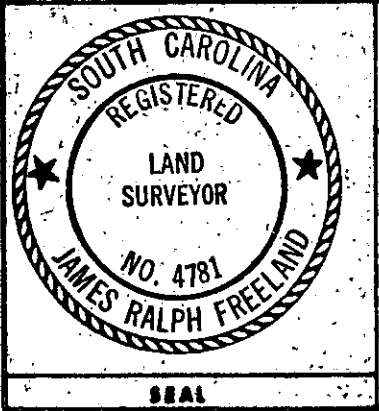

**STATE OF SOUTH CAROLINA**  
**GREENVILLE COUNTY**  
 DIXIE HEIGHTS  
 LOT 15 & PART 16  
 PROPERTY OF  
 KATHERINE S. YOUNG

FREELAND & ASSOCIATES Engineers • Land Surveyors GREENVILLE, S. C.	
SURVEY	RP
DRAWN	MLC
CHECK	MLC
SCALE	1" = 30'
DATE	2-22-79
DWG. NO.	79-2933

7-D-25 ✓ APR 3 1979

GCTC 1 AP 4 79 088 1.00CI