


MICROFILMED

FILED
GREENVILLE CO. S.C.
APR 10 9 25 AM '79
DONNIE S. TANKERSLEY
R.M.C.

CEDAR CREEK DRIVE
WATER IN ST R/W

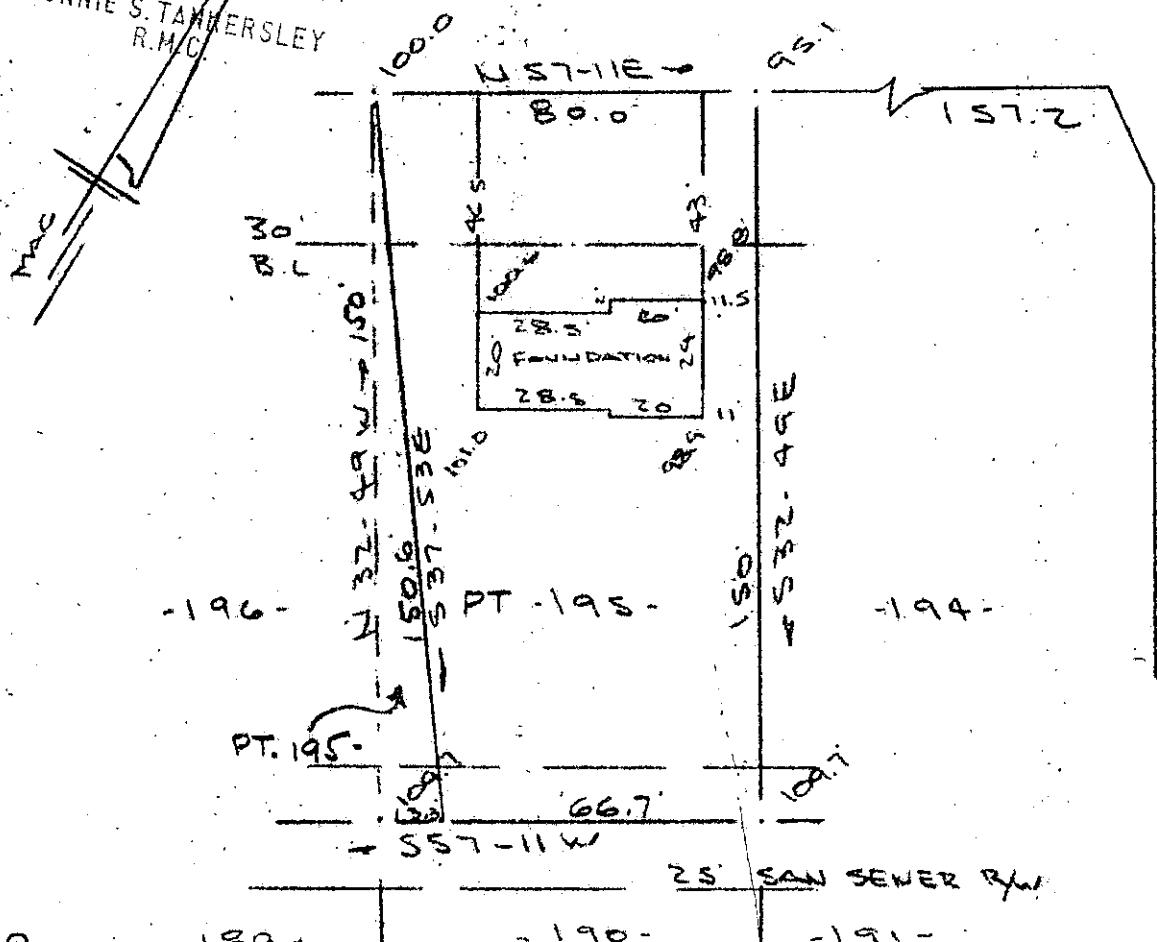

SURVEY FOR
BROWN ENTERPRISES OF S.C. INC.
NEAR GREENVILLE, SC.
SCALE 1":40 26 MAR 1979

GCTO -- 3 APR 10 79 1307

1.00CI

29301

CAROLINA SURVEYING CO.
112 MANLY ST.
GREENVILLE S.C.

7-D-37✓

R. B. Bruce #1982