MICROFILMED

FILED
GREENVILLE CO. S. C.
APR 10 11 34 AM '79
DONNIE S. TANKERSLEY
R.M.C.

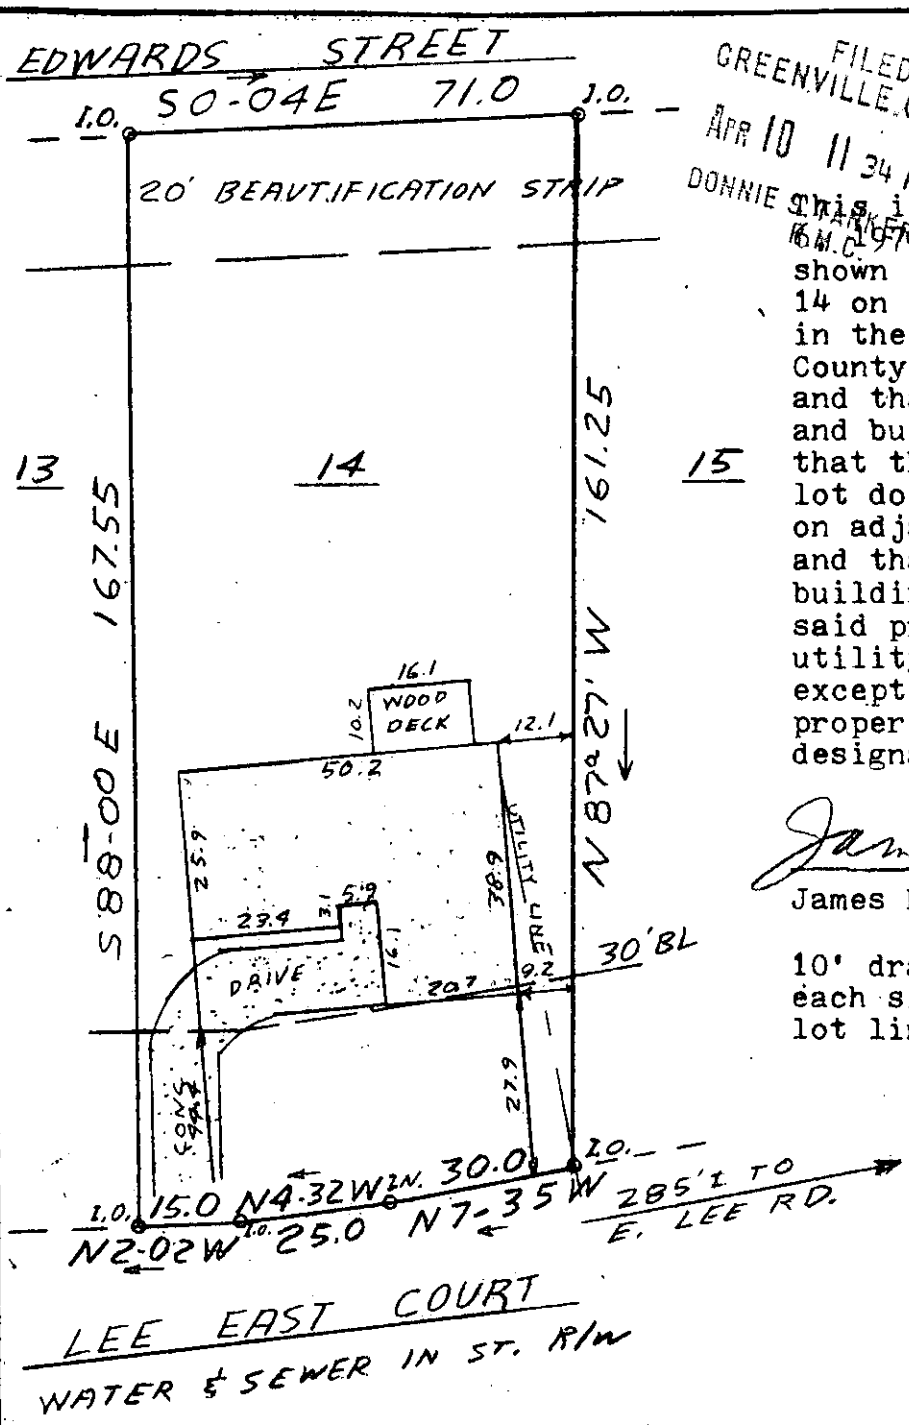

This is to certify that on April 6, 1979 I surveyed the property shown on this plat, known as Lot 14 on Plat of Lee East, recorded in the RMC Office of Greenville County in Plat Book 6H on Page 40, and that the property lines, walls and buildings are as shown hereon; that the building located on said lot does not encroach or project on adjacent streets or property, and that no adjacent walls or buildings encroach or project on said premises, and that no utility lines cross this property except as shown hereon. This property is not located in a designated flood hazard area.

James R. Freeland

James R. Freeland RLS & PE 4781

10' drainage & utility easement each side of all side & rear lot lines.

29355

7-D-40

SOUTH CAROLINA REGISTERED LAND SURVEYOR NO. 4781 JAMES RALPH FREELAND

SEAL

STATE OF SOUTH CAROLINA
GREENVILLE COUNTY

LEE EAST
LOT 14
PROPERTY OF
STEVEN K. SMITH & BRENDA B. SMITH

FREELAND & ASSOCIATES
Engineers • Land Surveyors
GREENVILLE, S. C.

SURVEY	DH
DRAWN	JRF
CHECK	m.c.
SCALE	1" = 30'
DATE	4-6-79
DWG. NO.	79-3147

GCTC --- 1 AP10 79 523 1.00CI