

MARION ROAD


WATER & SEWER IN ST. R/W.

MICROFILMED

FILED
GREENVILLE CO. S. C.

APR 20 3 16 PM '79

DONNIE S. TANKERSLEY
R.M.C.

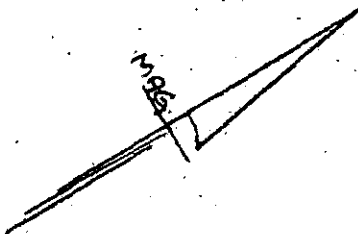

100 H 31-10 E

50

50

560

150.0
N 59-50 S 150.0

150.0
S 59-50 E 150.0

VIEW POINT DRIVE

- 101 -

- 102 -

- 103 -

- 104 -

- 76 -

- 75 -

- 74 -

- 73 -

NOTE: Improvements on this lot are not in a flood hazard area.

PROPERTY OF
BRYAN D. PRINCE
NEAR GREENVILLE, S.C.
SCALE 1" = 40

18 APRIL 1979

This is to certify that on the 18th day of April, 1979, I surveyed the property shown on this plat, being known as lots 102 & 103 on plat of PARKER HEIGHTS and recorded in the RMC Office Greenville County, S. C., in Plat Book " G " at Page 146; and that the property lines, walls and buildings are as shown hereon, and that the walls and buildings located on said lot do not encroach or project on adjacent street or property, and that no adjacent walls or buildings encroach or project on said premises, and no power lines cross this property except as shown hereon.

30684

R. B. Bruce
R. B. Bruce, RLS #1952



✓
2-D-86

CAROLINA SURVEYING CO.
112 Manly St.
Greenville, S. C.

GCTO ----- 3 APR 20 79 726

1.000CI