MICROFILMED

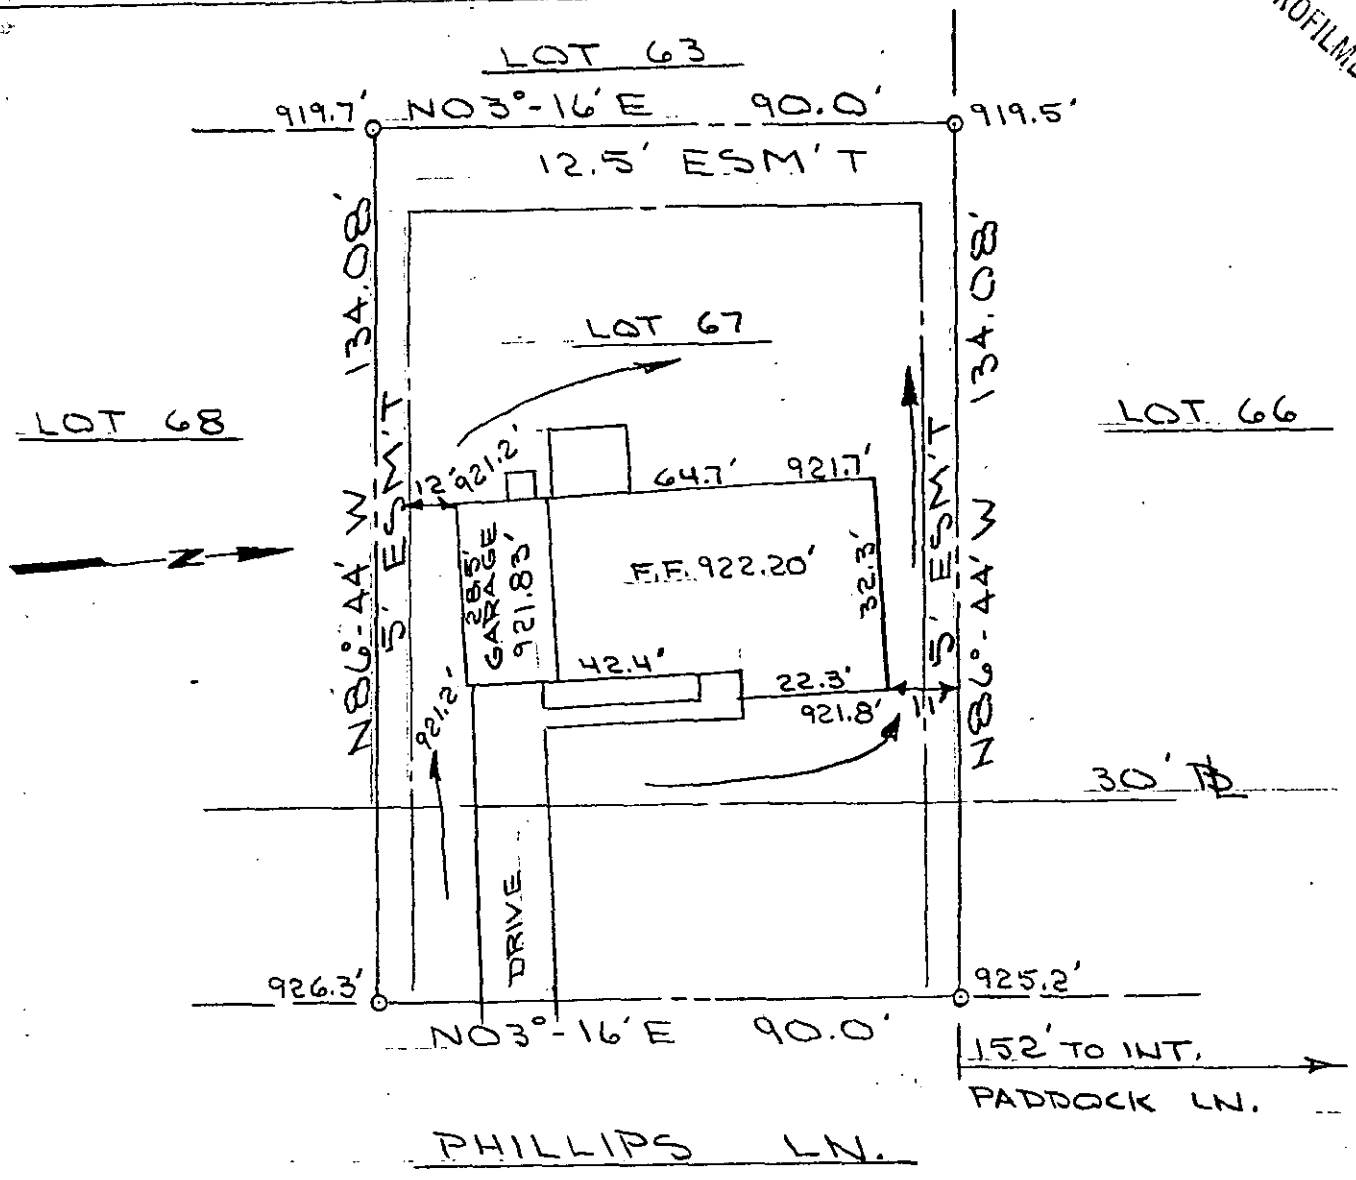

VAN, THANH DINH AND KIM CHI

Greenville County
South Carolina

Date: February 28, 1979
Scale: 1" = 30'

Plat and Building Location of Lot 67, Westminster Village, Section I, recorded in plat book _____, page _____, Office of R.M.C., belonging to Thanh Dinh Van and Kim Chi Van

I hereby certify that the measurements as shown on this plat are correct and there are no encroachments or projections other than shown.

30844

7-D-90

Registered Land Surveyor, S.C. #5571

HEANER ENGINEERING CO., INC.
GREENWOOD, S. C.

30 0 30 60

FILED
GREENVILLE CO. S.C.
APR 23 10 40 AM '79
DONNIE S. TANKERSLEY
R.M.C.

GCTC --- 1 AP23 79 1504 1.00CI