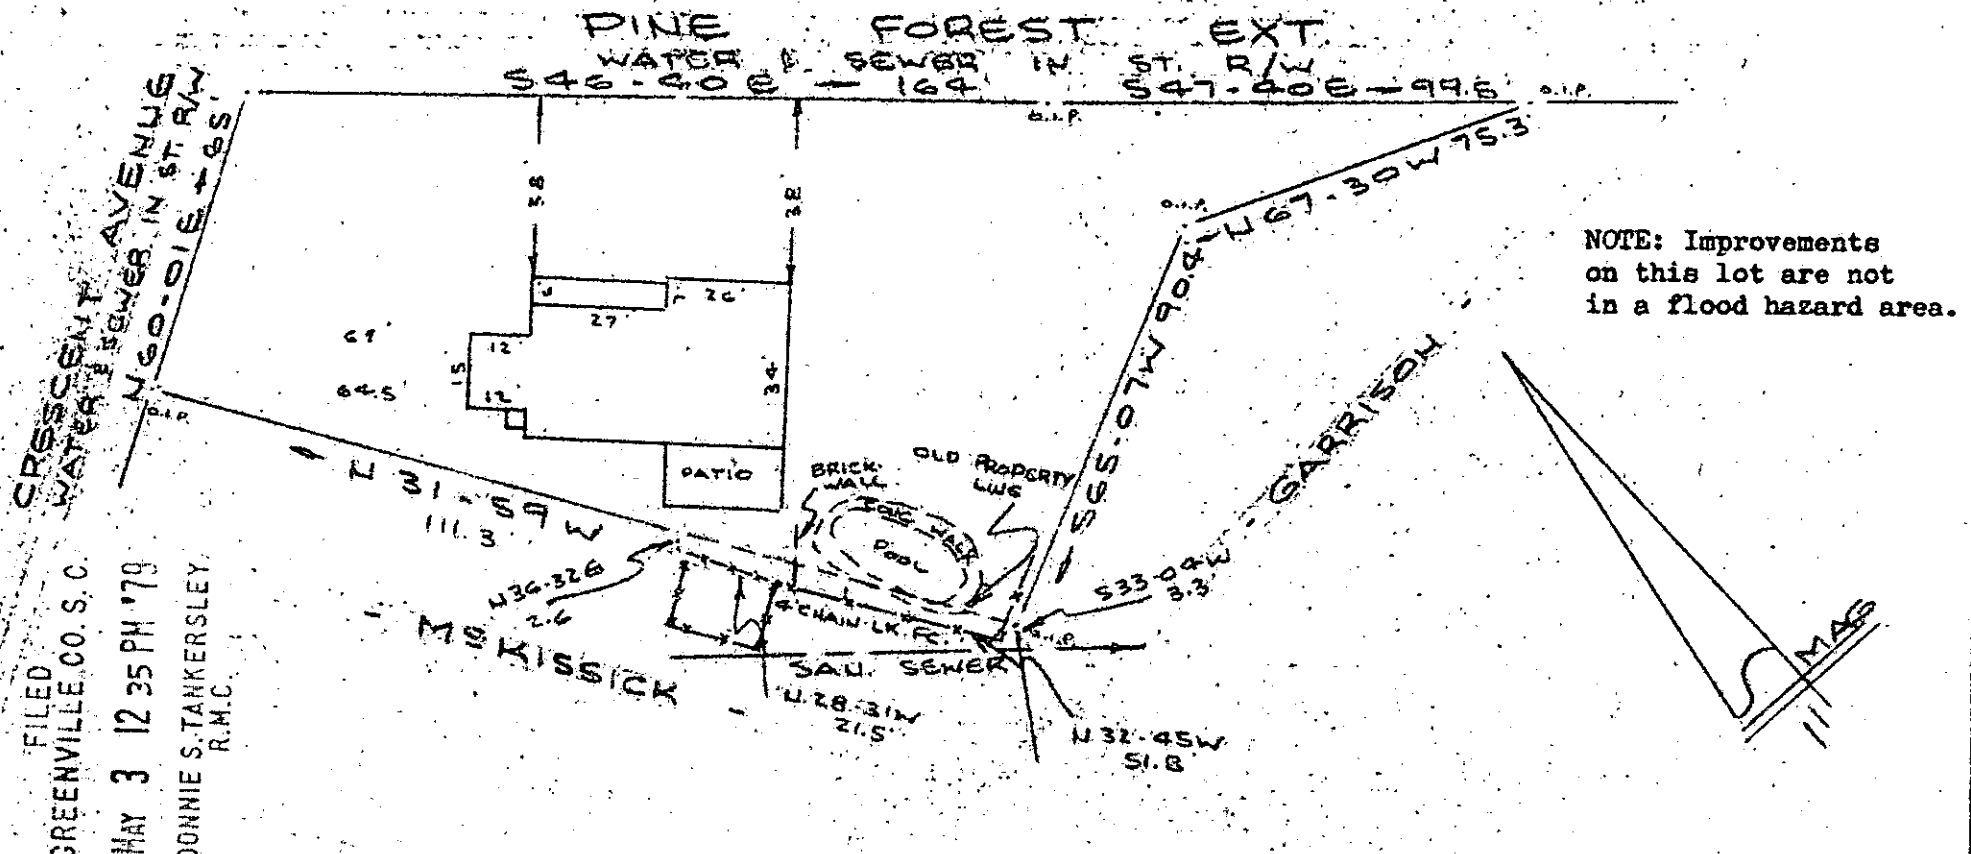

FILED
GREENVILLE CO. S. C.
MAY 3 12 35 PM '79
DONNIE S. TANKERSLEY
R.M.C.

PROPERTY OF
ROBERT A. ANDERS & EARL G. ANDERS
GREENVILLE, SOUTH CAROLINA
SCALE: 1" = 40' 23MAR1979

This is to certify that on the 23rd day of March, 1979, I surveyed the property shown on this plat, being known as PROPERTY OF ROBERT A. ANDERS & EARL G. ANDERS and recorded in the RMC Office Greenville County, S. C., in Plat Book at Page ; and that the property lines, walls and buildings are as shown hereon, and that the walls and buildings located on said lot do not encroach or project on adjacent street or property, and that no adjacent walls or buildings encroach or project on said premises, and no power lines cross this property except as shown hereon.

32108 MAY 3 1979

7-E-37

R. B. Bruce 1952
R. B. Bruco, RLS #1952

CAROLINA SURVEYING CO.
112 Manly St.
Greenville, S. C.

GCTO ----- 2 MY 79 1128 1.00CI

SOUTH CAROLINA REGISTERED R. B. BRUCE 1952

MICROFILMED

219/69

20Z-3-1.1

13423