


MICROFILMED

FILED  
GREENVILLE CO. S. C.  
MAY 25 4 12 PM '79  
DONNIE S. TANKERSLEY  
R.M.C.

LED BETTER ST

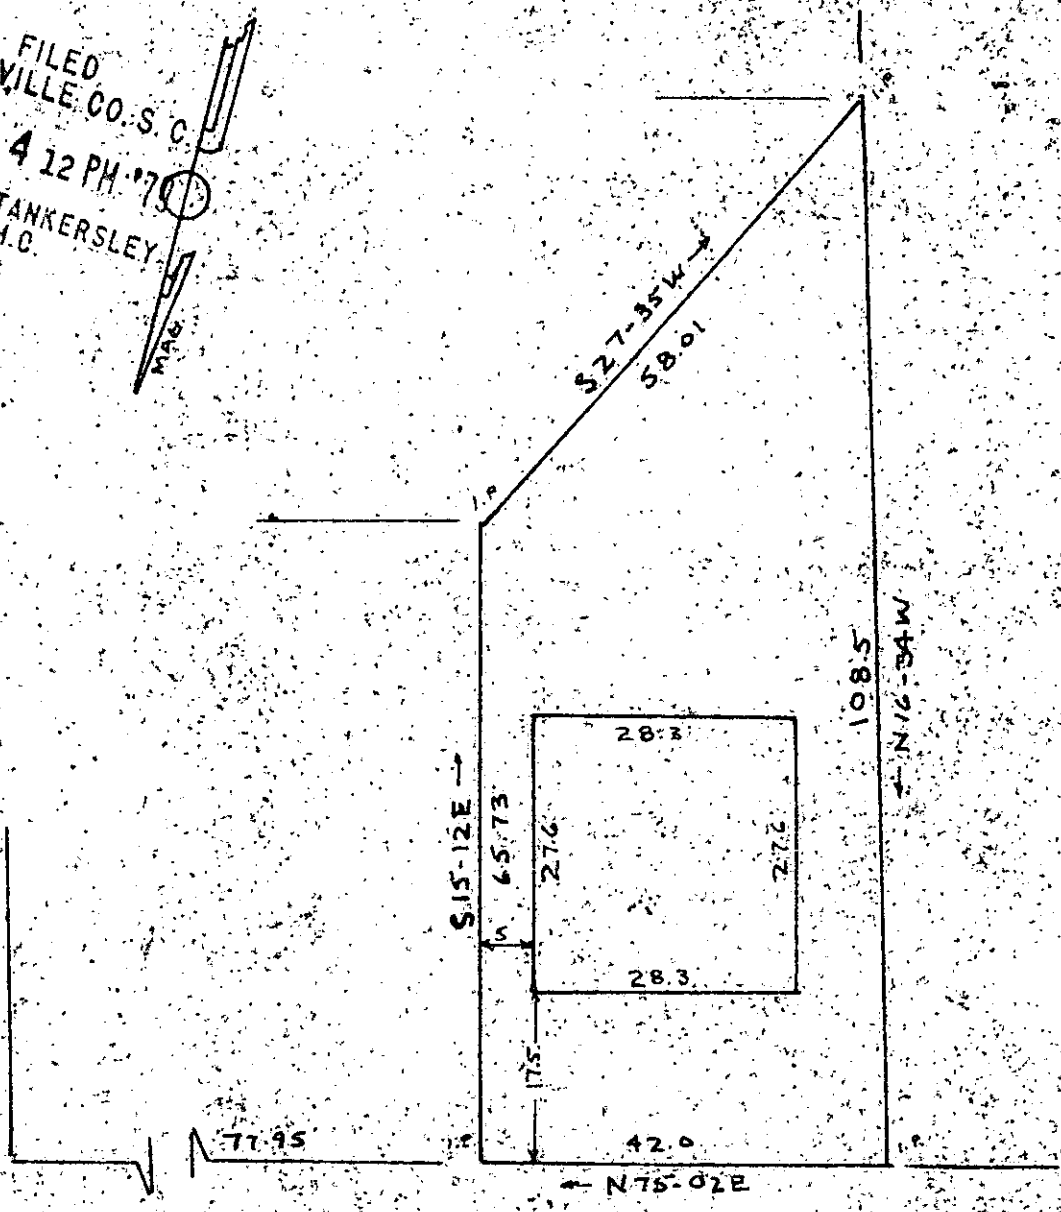

CALVERT ST

I hereby certify that on May 21, 1978 I resurveyed the above parcel and that the property lines, buildings, and walls are as shown hereon; that no walls or buildings encroach on adjacent streets or property and no buildings or walls encroach or project on these premises and that the structures are not within a flood hazard area.

*Charles F. Webb*  
Charles F. Webb R.L.S.

CHARLES F. WEBB  
REGISTERED  
1577  
LAND SURVEYOR  
SOUTH CAROLINA

D.F. 26

PROPERTY OF
ROBERT C. TURNER
SANDRA E. LESLEY TURNER
NEAR THE CITY OF GREENVILLE
GREENVILLE COUNTY S.C.
WEBB SURVEYING & ENGINEERING CO.
SCALE 1" = 20' MAY 21 1978
2 MAY 25 1979 1455 1.0001
BLK. GK. REF. 117-5-PT. 3

MAY 25 1979