


FILED
GREENVILLE, CO. S. C.
MAY 31 3 15 PM '79
DONNIE S. TANKERSLEY
R.M.C.

MICROFILMED

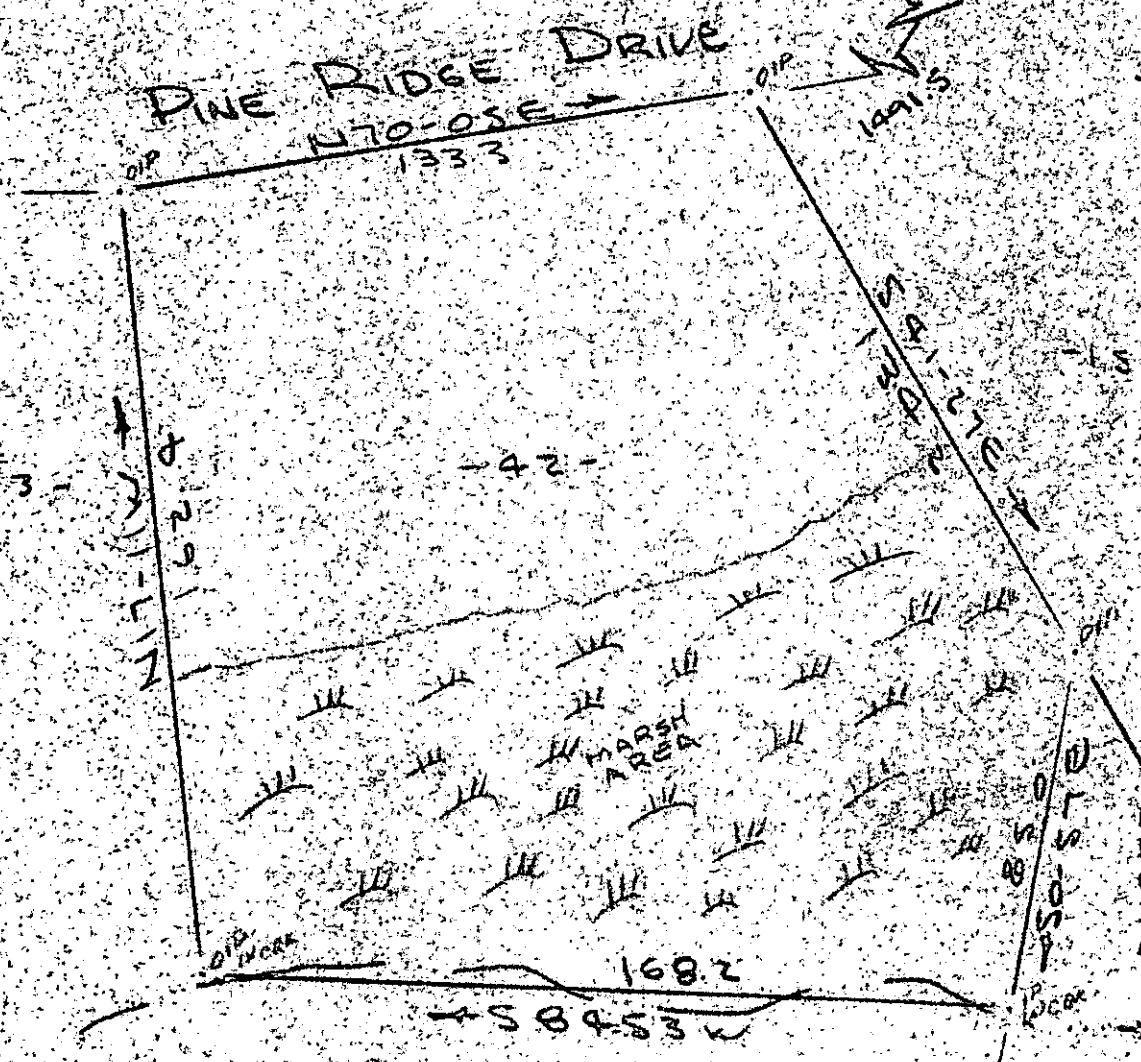

NOTE:
NORTHERN PORTION
OF THIS LOT IS NOT
IN A FLOOD HAZARD
AREA.

PROPERTY OF
W. FRANKLIN CASE & FRANK B. HAMMOND
NEAR GREENVILLE, S.C.
SCALE 1" = 40' 25 MAY 1979

This is to certify that on the 25th day of May, 1979, I surveyed the property shown on this plat, being known as lot 42 on plat of PROPERTY OF W. FRANKLIN CASE & FRANK B. HAMMOND and recorded in the R.M. Office Greenville County, S. C., in Plat Book at Page ; and that no adjacent walls or buildings encroach or project on said premises, and no power lines cross this property except as shown hereon.

R. B. Bruce


R. B. Bruce, S.S. 1952

M-F-59

35293

MAY 31 1979

CAROLINA SURVEYING CO.
112 Manly St.
Greenville, S. C.

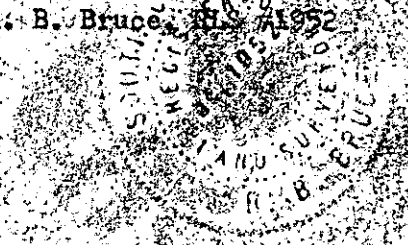

GCTG
1 MY 31 1979
433
1.0001