


JUN 1 12 36 PM '79

DONNIE S. TANKERSLEY
R.M.C.

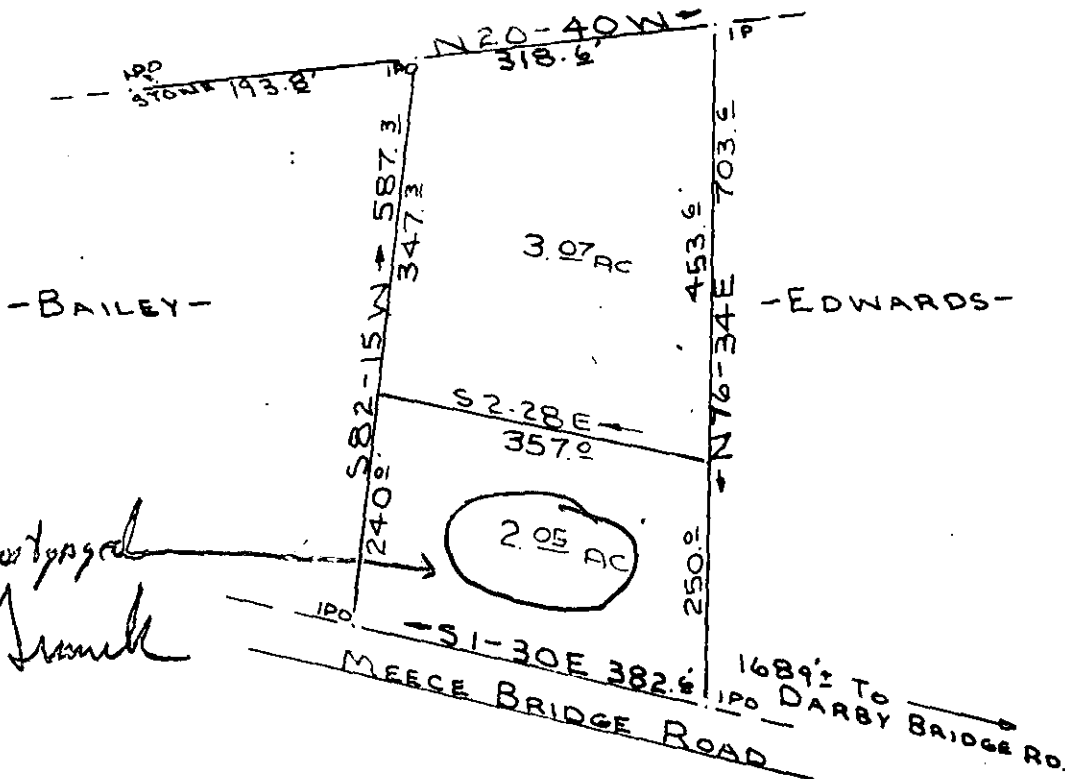

-COLEMAN-



JUN 1 1979

66372 11M 4E

7F 63

35614



SURVEY FOR
BOBBY J. LISTER
ONEAL TWP. GREENVILLE CO.
SOUTH CAROLINA
APRIL 17, 1973
REVISED APRIL 27, 1979
DIVISION LINE COMPUTED
W.R. Williams, Jr.

W.R. WILLIAMS, JR. RLS. # 3979
TRAVELERS REST, S.C.

SCALE 1" = 200'