


MICROFILMED

Hampton Investors
Corporatio of
Greenville, Inc.

FILED
GREENVILLE CO. S. C.
JUN 4 3 47 PM '79
DONNIE S. TANKERSLEY
R.M.C.

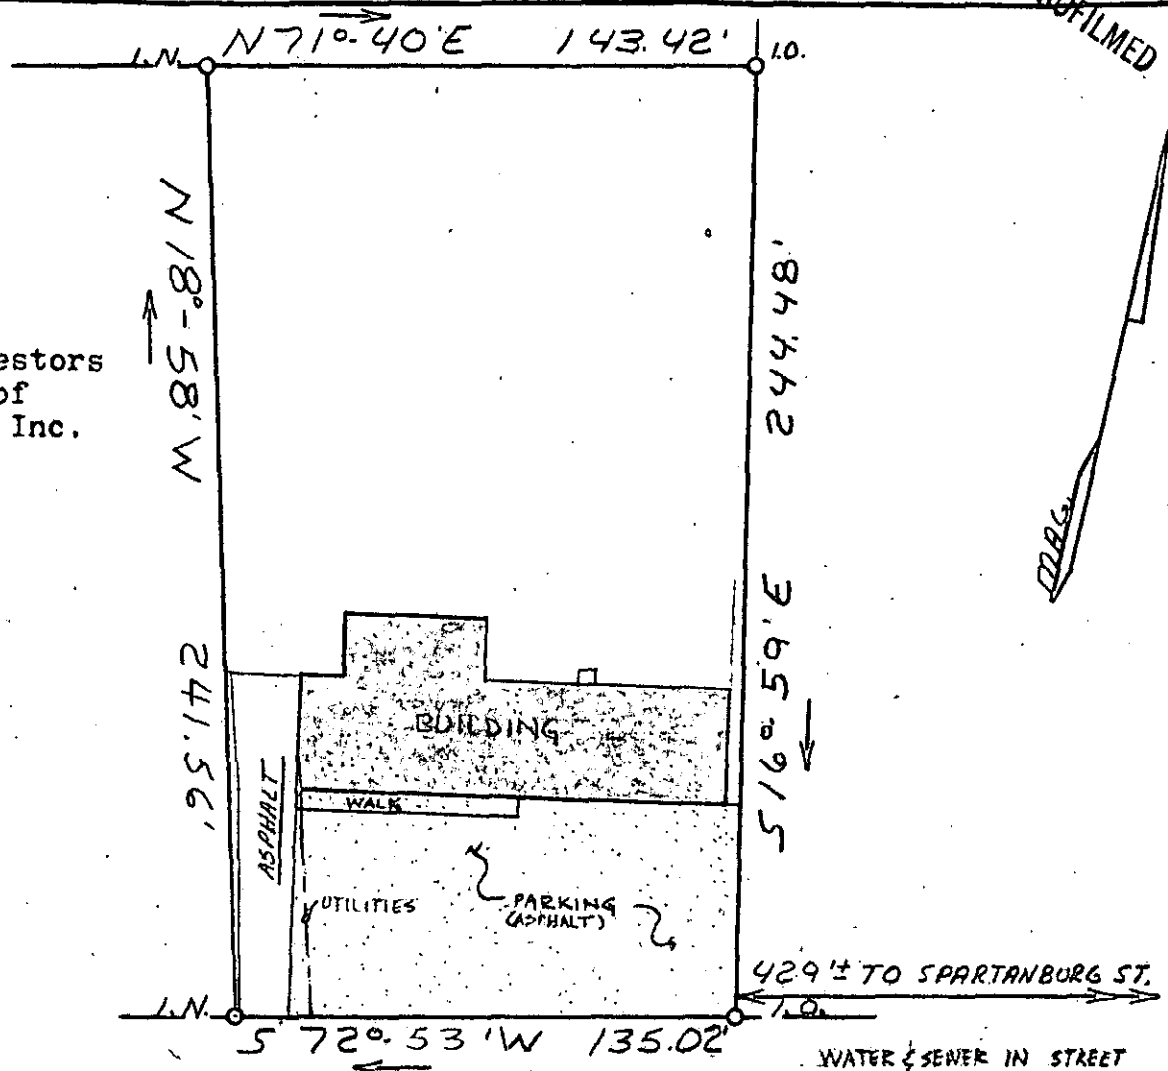

EAST NORTH STREET


This is to certify that on May 3, 1979, I surveyed the property shown on this plat known as Property of Uldrick Construction Co.-Inc. recorded in the RMC Office of Greenville County in Plat Book GGG on Page 182, and that the property lines, walls, and buildings are as shown hereon; that the building located on said lot does not encroach or project on adjacent streets or property, and that no adjacent walls or buildings encroach or project on said premises, and that no utility lines cross this property except as shown hereon. This property is not located in a designated flood hazard area.

35904

James R. Freeland
 James R. Freeland RLS & PE 4781

7F-73

JUN 4 1979

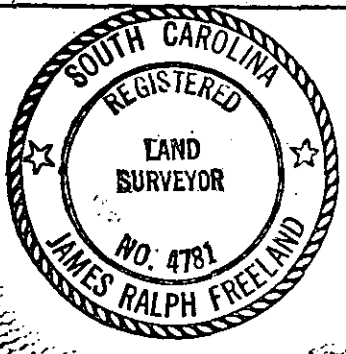

STATE OF SOUTH CAROLINA
 GREENVILLE COUNTY
 PROPERTY OF
 RICHARD O. FARNSWORTH

FREELAND & ASSOCIATES
 Engineers • Land Surveyors
 GREENVILLE, S. C.

SURVBY *B.H.*
 DRAWN *M.C.*
 CHECK *MC*
 SCALE 1"=50'
 DATE 5-3-79
 D.W. NO. 79-3254-5

GCTO -----3 JUN. 4 79

8041