


FILED  
GREENVILLE CO. S. C.  
JUN 5 10 00 AM '79  
DONNIE S. TANKERSLEY  
R.M.C.

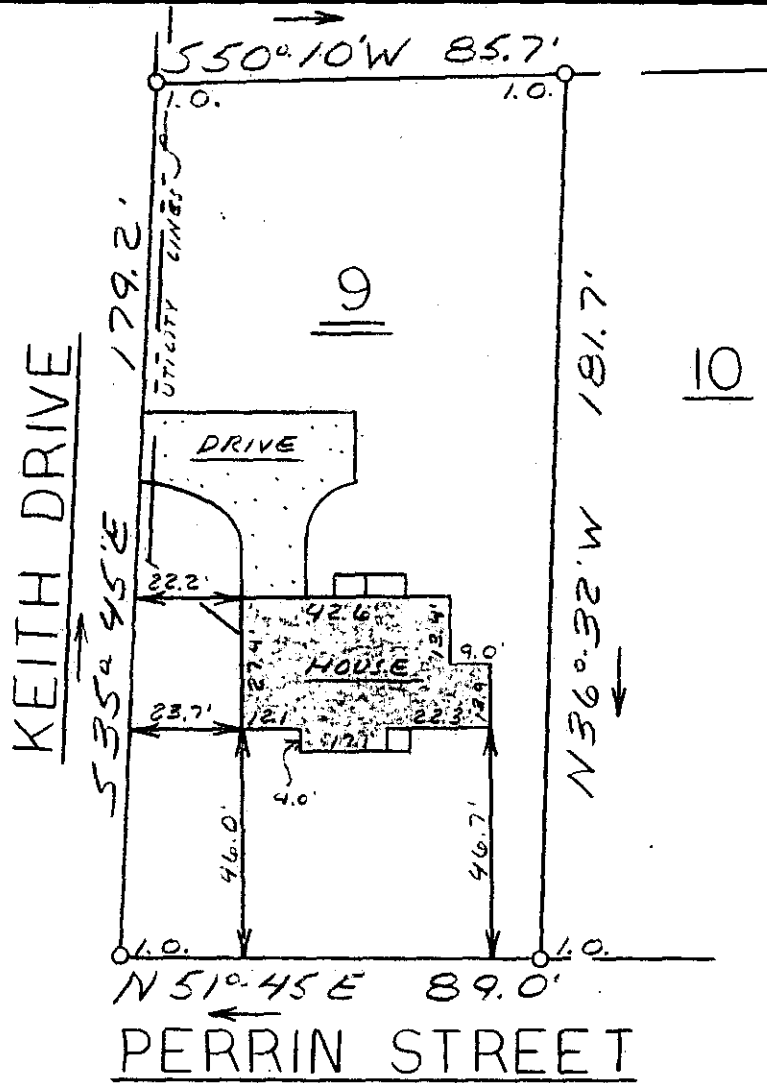

WATER & SEWER IN ST. R/W

This is to certify that on May 31, 1979, I surveyed the property shown on this plat, known as Lot 9 on Plat of A.A. Green Property, recorded in the BMC Office of Greenville County in Plat Book M on Page 145, and that the property lines, walls and buildings are as shown hereon; that the building located on said lot does not encroach or project on adjacent streets or property, and that no adjacent walls or buildings encroach or project on said premises, and that no utility lines cross this property except as shown hereon. This property is not located in a designated flood hazard area.

JUN 5 1979

JUN 5 1979  
7.F-74

36054

*James R. Freeland*  
James R. Freeland RLS & PE 4781



**STATE OF SOUTH CAROLINA  
GREENVILLE COUNTY**

**A.A. GREEN PROPERTY**

**LOT 9**

**PROPERTY OF**  
**ANDREW A. PHILLIPS &**  
**ALICE C. PHILLIPS**

**FREELAND & ASSOCIATES**  
Engineers • Land Surveyors

GREENVILLE, S.C.

SURVEY *J.A.*  
DRAWN *M.C.*  
CHECK *M.C.*  
SCALE  $1'' = 40'$   
DATE *5-31-79*  
DWG. NO. *79-3424*