

MICROFILMED


FILED
GREENVILLE CO. S. C.

JUN 5 3 32 PM '79

DONNIE S. TANKERSLEY
R.M.C.

DEL NORTE LANE
WATER & SEWER IN ST. RUN

SHERBORNE DR.

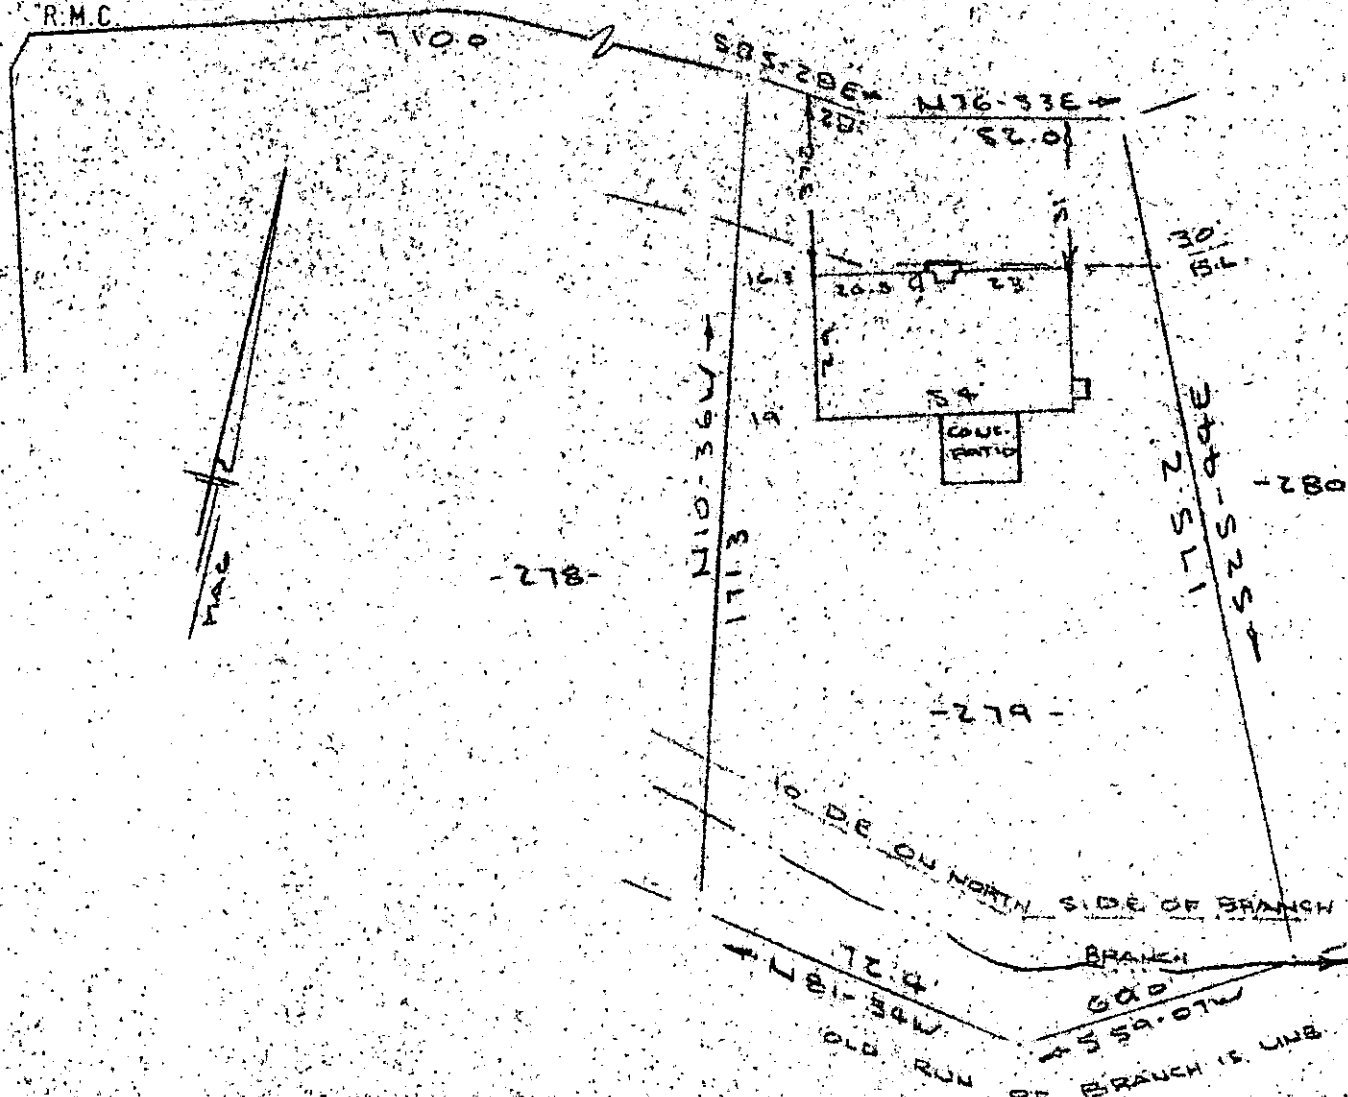

PROPERTY OF

JAMES E. JOHNSTON III & JOHN H. HANSBOROUGH
NEAR GREENVILLE S.C.
SCALE 1" = 40' 13 JUNE 1979

This is to certify that on the 1st day of June, 1979, I surveyed the property shown on this plat, being known as lot 279 on plat of Section 3 Del Norte and recorded in the RMC Office Greenville County, S. C., in Plat Book "A - N" at Pages 12 & 13; and that the property lines, walls and buildings are as shown hereon; and that the walls and buildings located on said lot do not encroach or project on adjacent street or property, and that no adjacent walls or buildings encroach or project on said premises, and no power lines cross this property except as shown hereon.

JUN 5 1979

17F-79

36059

R. B. Bruce
R. B. Bruce, RLS 1952-0

CAROLINA SURVEYING CO.
112 Manly St.
Greenville, S. C.

GC10 --- JUN 5 1979 287 1.00CI

214 @ 35

538.10-1-279

R. B. Bruce