

The undersigned certifies that the boundary for the property was drawn from an actual survey dated May, 1979 made by me and that the courses and distances are true and correct, that the buildings and improvements located thereon are accurately located, that the building and improvements do not encroach or project over the boundary lines.

*R.W. Linton*  
S.C. Reg. No. 916

408 NORTH CHURCH STREET  
HORIZONTAL PROPERTY REGIME


GREENVILLE, S. C.

Scale 1" = 20' May, 1979

DALTON & NEVES CO., ENGINEERS  
DONNIE S. TANKERSLEY R.M.C.

121 MANLY STREET

GREENVILLE S. C.

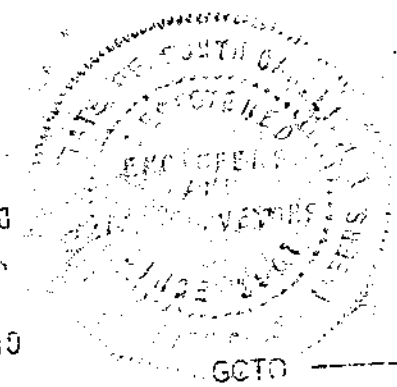

- 2758
- LEGEND
1. The additional sheets of this Exhibit show typical floor plans for the unit, their location in the building, and a typical front building elevation.
  2. Each unit consists of the space bounded by the undercoated and/or unfinished surfaces of the perimeter walls, floors, and ceilings.
  3. Common Elements: — — — —
  4. Limited Common Elements - Stairs [ ] [ ] [ ] [ ]

✓ 7-G-40

FILED JUL 24 1979 742

AREA = 0.576 Acres