


MICROFILMED

FILED
GREENVILLE CO. S.C.
JUN 12 4 04 PM '79
DONNIE S. TANKERSLEY
R.M.C.

BOHAR ST.

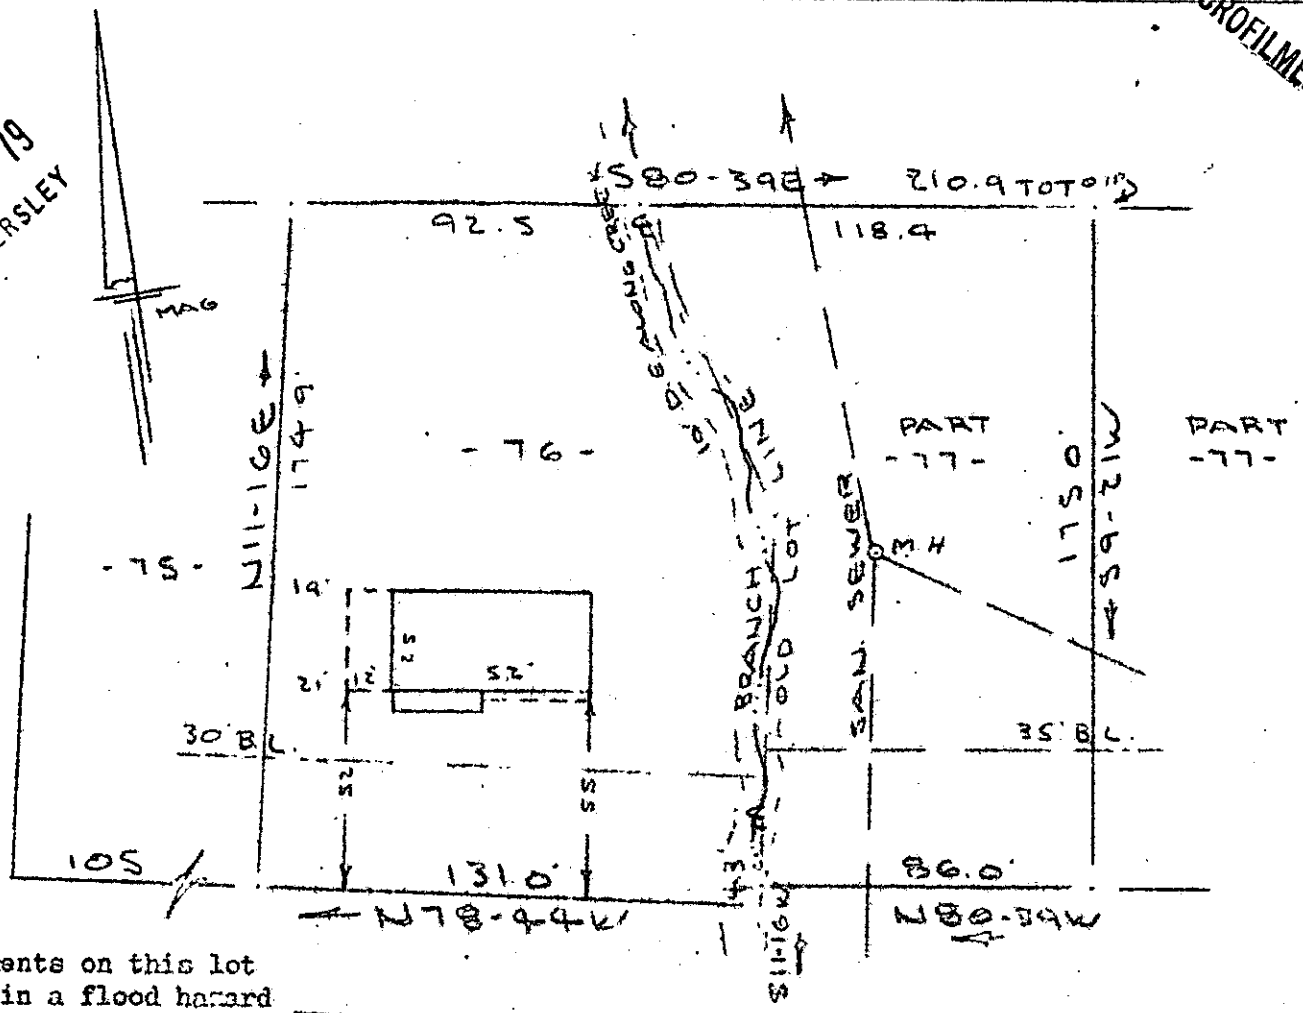

NOTE:
Improvements on this lot
are not in a flood hazard
area.

FAIRFIELD DRIVE
WATER & SEWER IN ST. R/W

PROPERTY OF
CALVIN E. WEEKS & NANCY I. WEEKS
NEAR GREENVILLE, S.C.
SCALE: 1" = 50'
12 JUNE 1979

GCTO
3
JUN 12 1979
1106

1.0001

This is to certify that on the 12th day of June, 1979, I surveyed the property shown on this plat, being known as lot 76 and part of lot 77 on plat of GLENDALE and recorded in the REC Office Greenville County, S. C., in Plat Book "QQ" at Pages 76 & 77 and also being known as PROPERTY OF CALVIN E. WEEKS & NANCY I. WEEKS and recorded in Plat Book 74 at Page 16 ; and that the property lines, walls and buildings are as shown hereon, and that the walls and buildings located on said lot do not encroach or project on adjacent street or property, and that no adjacent walls or buildings encroach or project on said premises, and no power lines cross this property except as shown hereon.

JUN 12 1979
✓ 7-H-16

36866 R. B. Bruce

R. B. Bruce, R.M.C. 1952

CAROLINA SURVEYING
112 Manly
Greenville, S. C.

REC'D
JUN 13 1979
R. B. BRUCE
S. C. SURVEYOR