


MICROFILMED

AF 10505

JUN 29 4 07 PM '79
DONNIE S. TANKERSLEY
R.M.C.

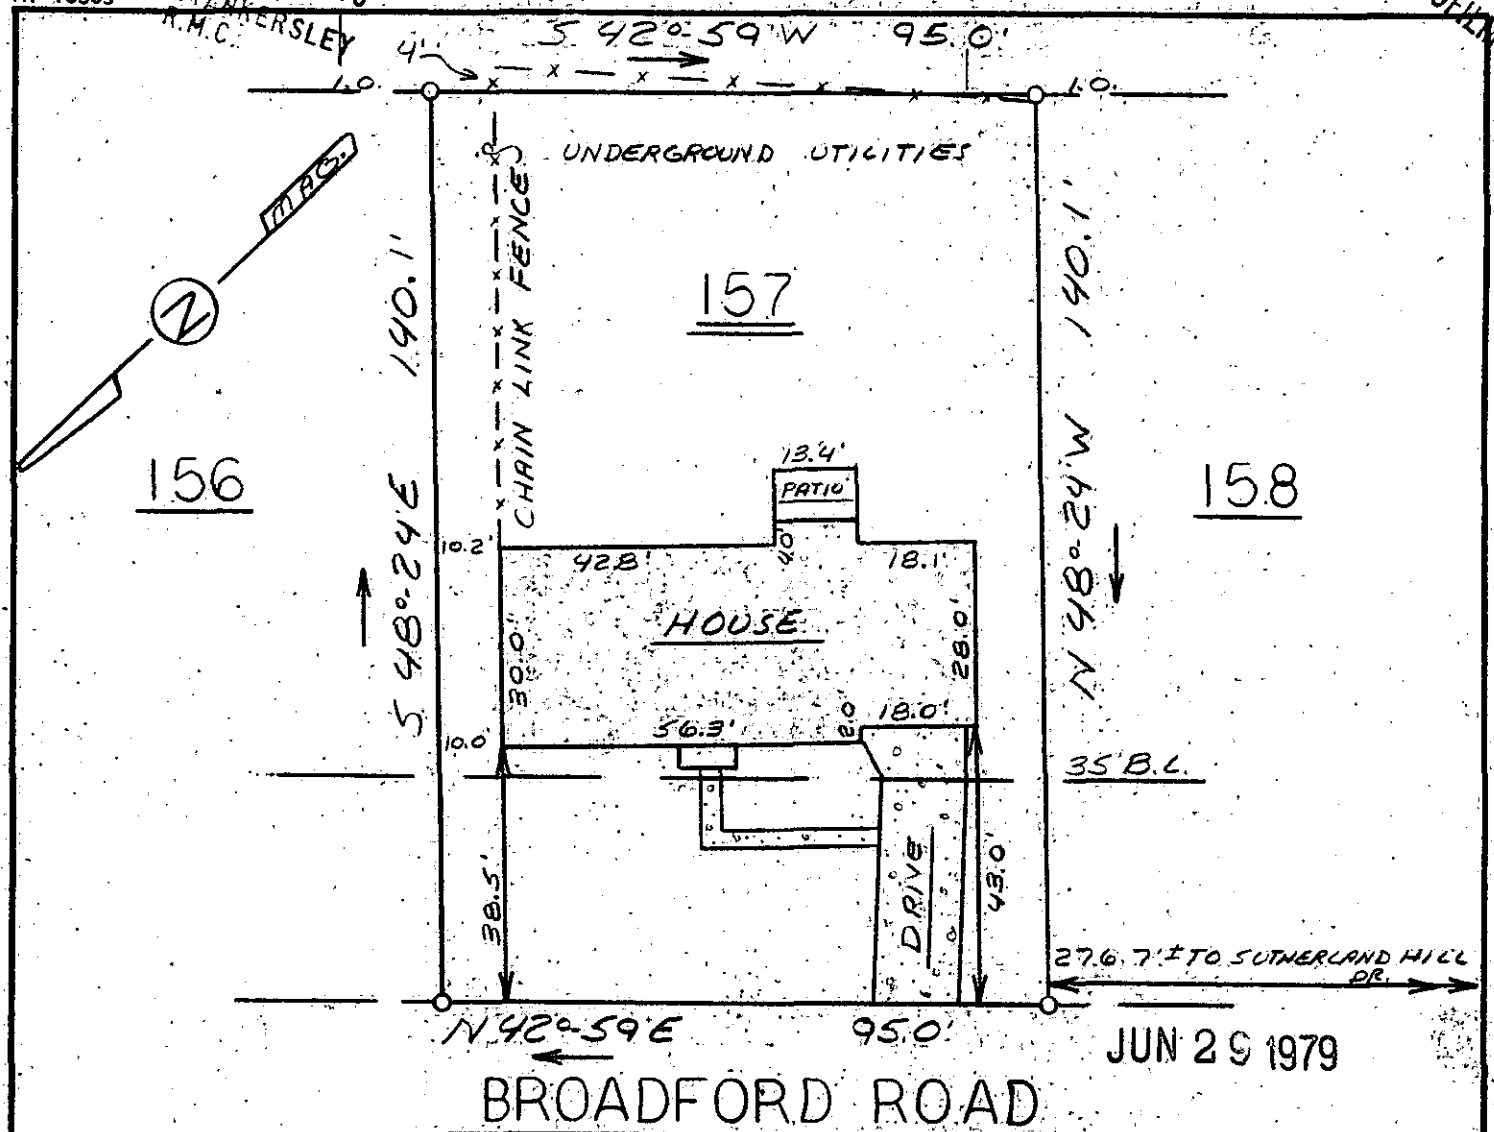

JUN 29 1979


BROADFORD ROAD

This is to certify that on June 26, 1979, I surveyed the property shown on this plat, known as Lot 157 on Plat of Del Norte Estates, Sec. 4, recorded in the RMC Office of Greenville County in Plat Book WWW on Page 32, and that the property lines, walls and buildings are as shown hereon; that the building located on said lot does not encroach or project on adjacent streets or property, and that no adjacent walls or buildings encroach or project on said premises, and that no utility lines cross this property except as shown hereon. This property is not located in a designated flood hazard area.

39053

James R. Freeland
 James R. Freeland RLS & PE 4781

7-H-87

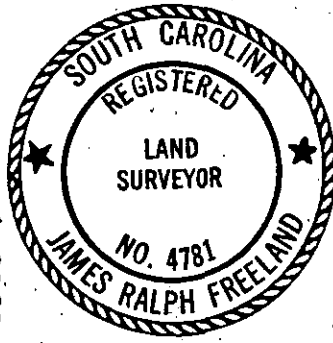

**STATE OF SOUTH CAROLINA
 GREENVILLE COUNTY**

DEL NORTE ESTATES
 SEC. 4 - LOT 157
 PROPERTY OF
 EUGENE J. GODBOLD JR.
 &
 BELINDA R. GODBOLD

FREELAND & ASSOCIATES
 Engineers • Land Surveyors

GREENVILLE, S.C.

SURVEY	J.A.
DRAWN	M.C.
CHECK	M.C.
SCALE	1" = 30'
DATE	6-26-79
DWG. NO.	79-3560

CGTC
11/29/79 1583
1983