

MICROFILMED


JUL 11 1979

FILED

GREENVILLE CO. S.C.


JUL 11 10 35 AM '79

DONNIE S. TANKERSLEY
R.M.C.

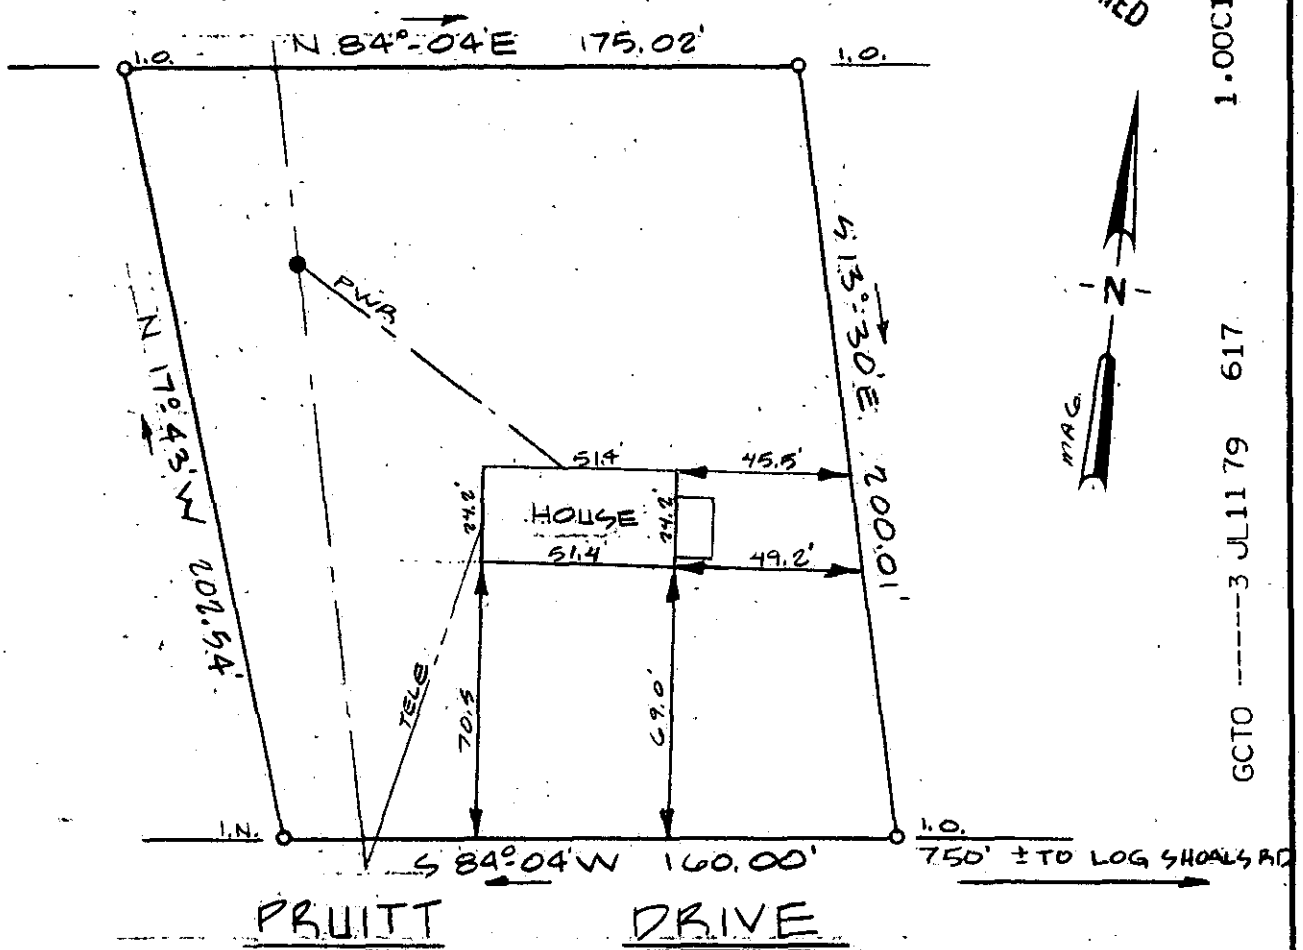

1.00CI

GCTO -----3 JUL 11 79 617

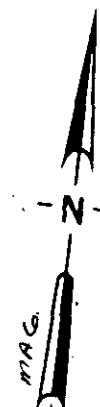

PRUITT DRIVE

This is to certify that on July 10, 1979; I surveyed the property shown on this plat, known as Property of R. D. Babb recorded in the R.M.C. Office of Greenville County in Deed Book 1033 on Page 666, and that the property lines walls and buildings are as shown hereon, that the building located on said lot does not encroach or project on adjacent streets or property, and that no adjacent, and that no adjacent walls or buildings encroach or project on said premises, and that no utility lines cross this property except as shown hereon. This property is not located in a designated flood area.

James R. Freeland
James R. Freeland R.L.S. & P.E.
4781

7-8-28 ✓

1116



M 6.1-1-B.4



SEAL

**STATE OF SOUTH CAROLINA
GREENVILLE COUNTY**

PROPERTY OF

DANIEL B. DAVIS

&

DEBORAH E. DAVIS

FREELAND & ASSOCIATES
Engineers • Land Surveyors

GREENVILLE, S.C.

SURVEY	BP
DRAWN	FEL
CHECK	MC
SCALE	1" = 50'
DATE	7/10/79
DWG. NO.	79-3635