


MICROFILMED

FILED  
GREENVILLE CO. S. C.  
JUL 12 10 04 AM '79  
DONNIE S. TANKERSLEY  
R.M.C.

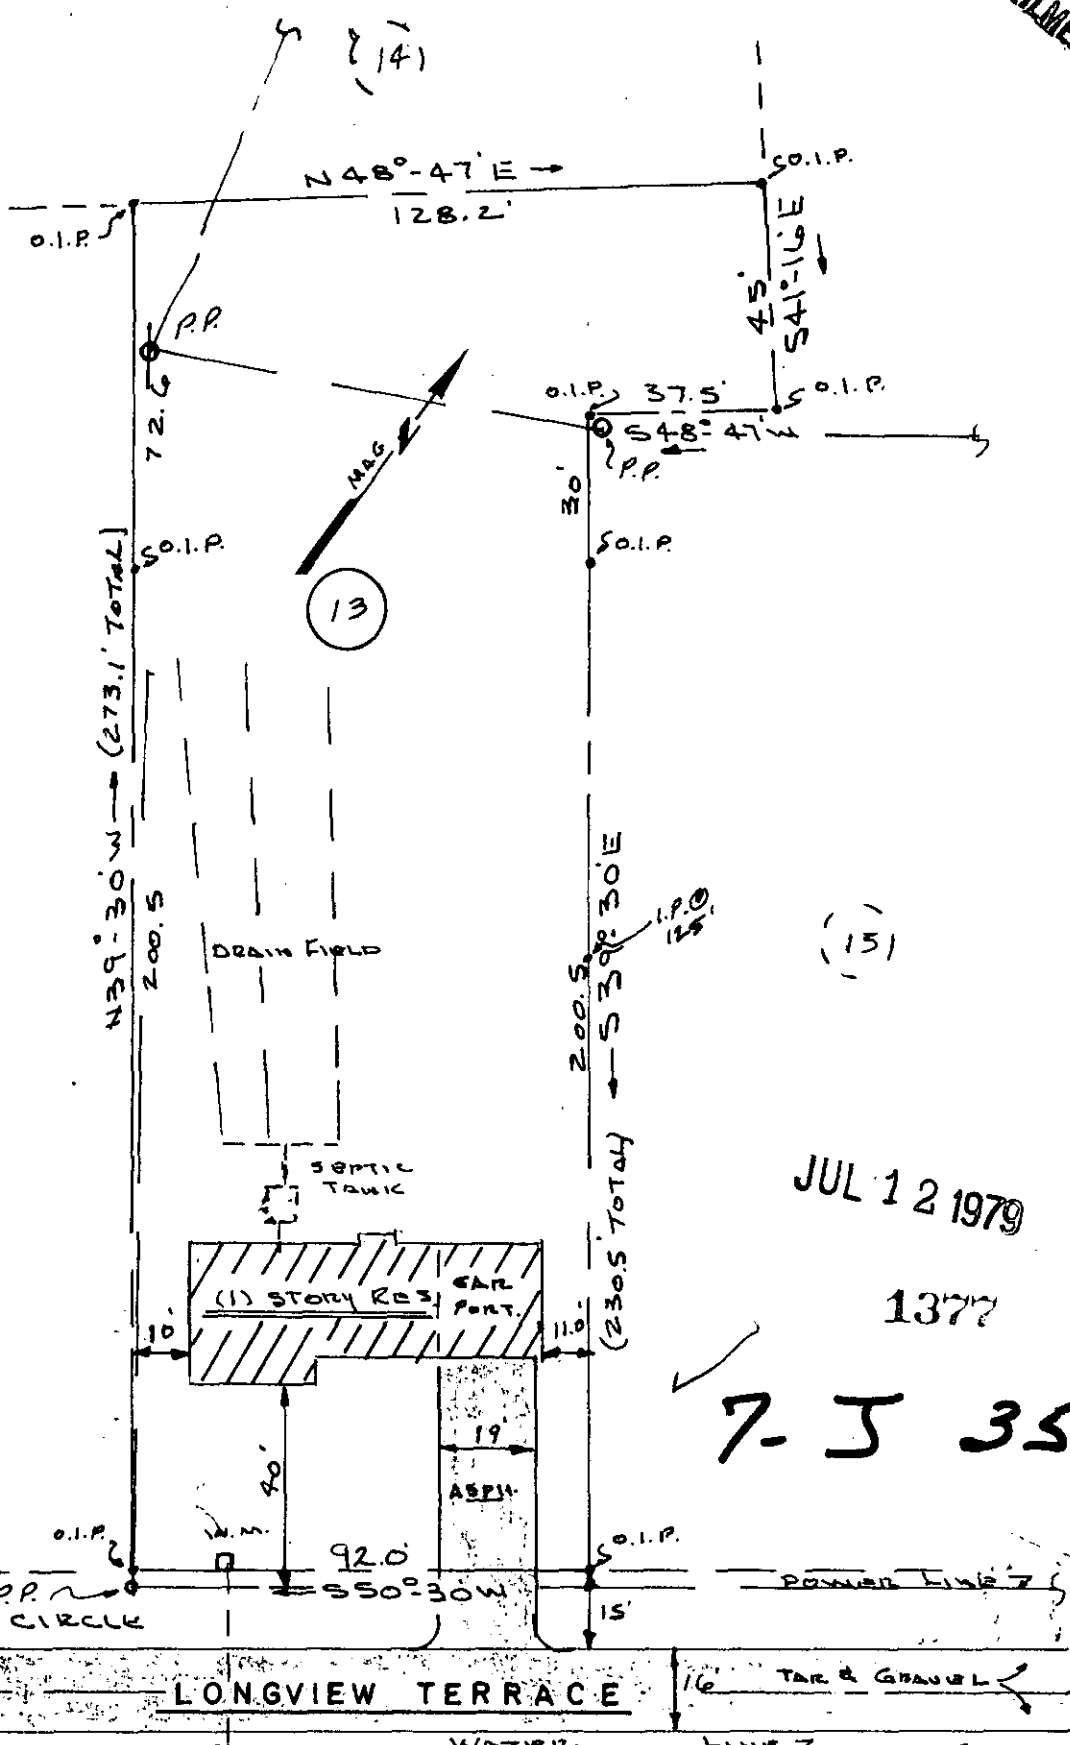

JUL 12 1979

1377


7-5-35

GCTO  
1 JUL 12 1979  
1216

I CERTIFY THE ABOVE TRACT HAS BEEN RE-SURVEYED AND BUILDING ARE LOCATED AS SHOWN.

CHICK SPRINGS TOWNSHIP  
REF. DEED BK. 1100 PG. 563  
BLK. BK. 535-1-89  
PLT. BK. 7-D PG. 64

*Kenneth J. Gould*  
S.C. REG. NO 4035

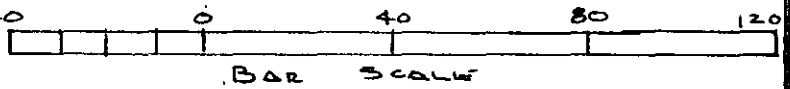

Seal 	PROPERTY OF	Drawn By K. T. G.
	CHARLES H. BABB	Checked By
	& DONNA R. CAMPBELL	Scale 1" = 40'
	GOULD & ASSOC SURVEYORS	Date 7-5-79
	TAYLORS, S. C.	File No.
		Dwg. No.