

PROPERTY OF
MICHAEL O. BRADFORD
 GREENVILLE CO, S.C.

Scale 1" = 40' July, 1979

This is to certify that on the 11th day of July, 1979, We surveyed the property shown on this plat; being known as part Lot 4 on plat of Eliza D. Ware, Recorded in Plat Book M, page 27, Office of R. M. C. Greenville County, S. C.; and that the property lines, walls and buildings are as shown hereon; that the buildings located on said lot do not encroach or project on adjacent streets or property; and that no adjacent buildings or walls encroach or project on said premises; and from information from Greenville County, this structure is not in a designated flood area.


7-2-44

1744

William J. Neves
 DALTON & NEVES CO., ENGINEERS.

F. B. 229
 S. C. Reg. No. 6266

GREENVILLE CO. S.C.
 JUL 16 8 46 AM '79
 DONNIE S. TANKERSLEY
 R.M.C.

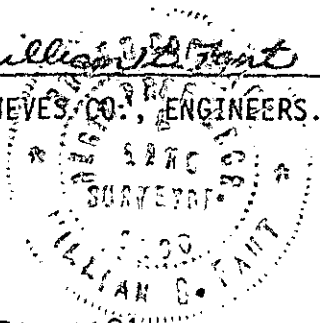

1.0001