
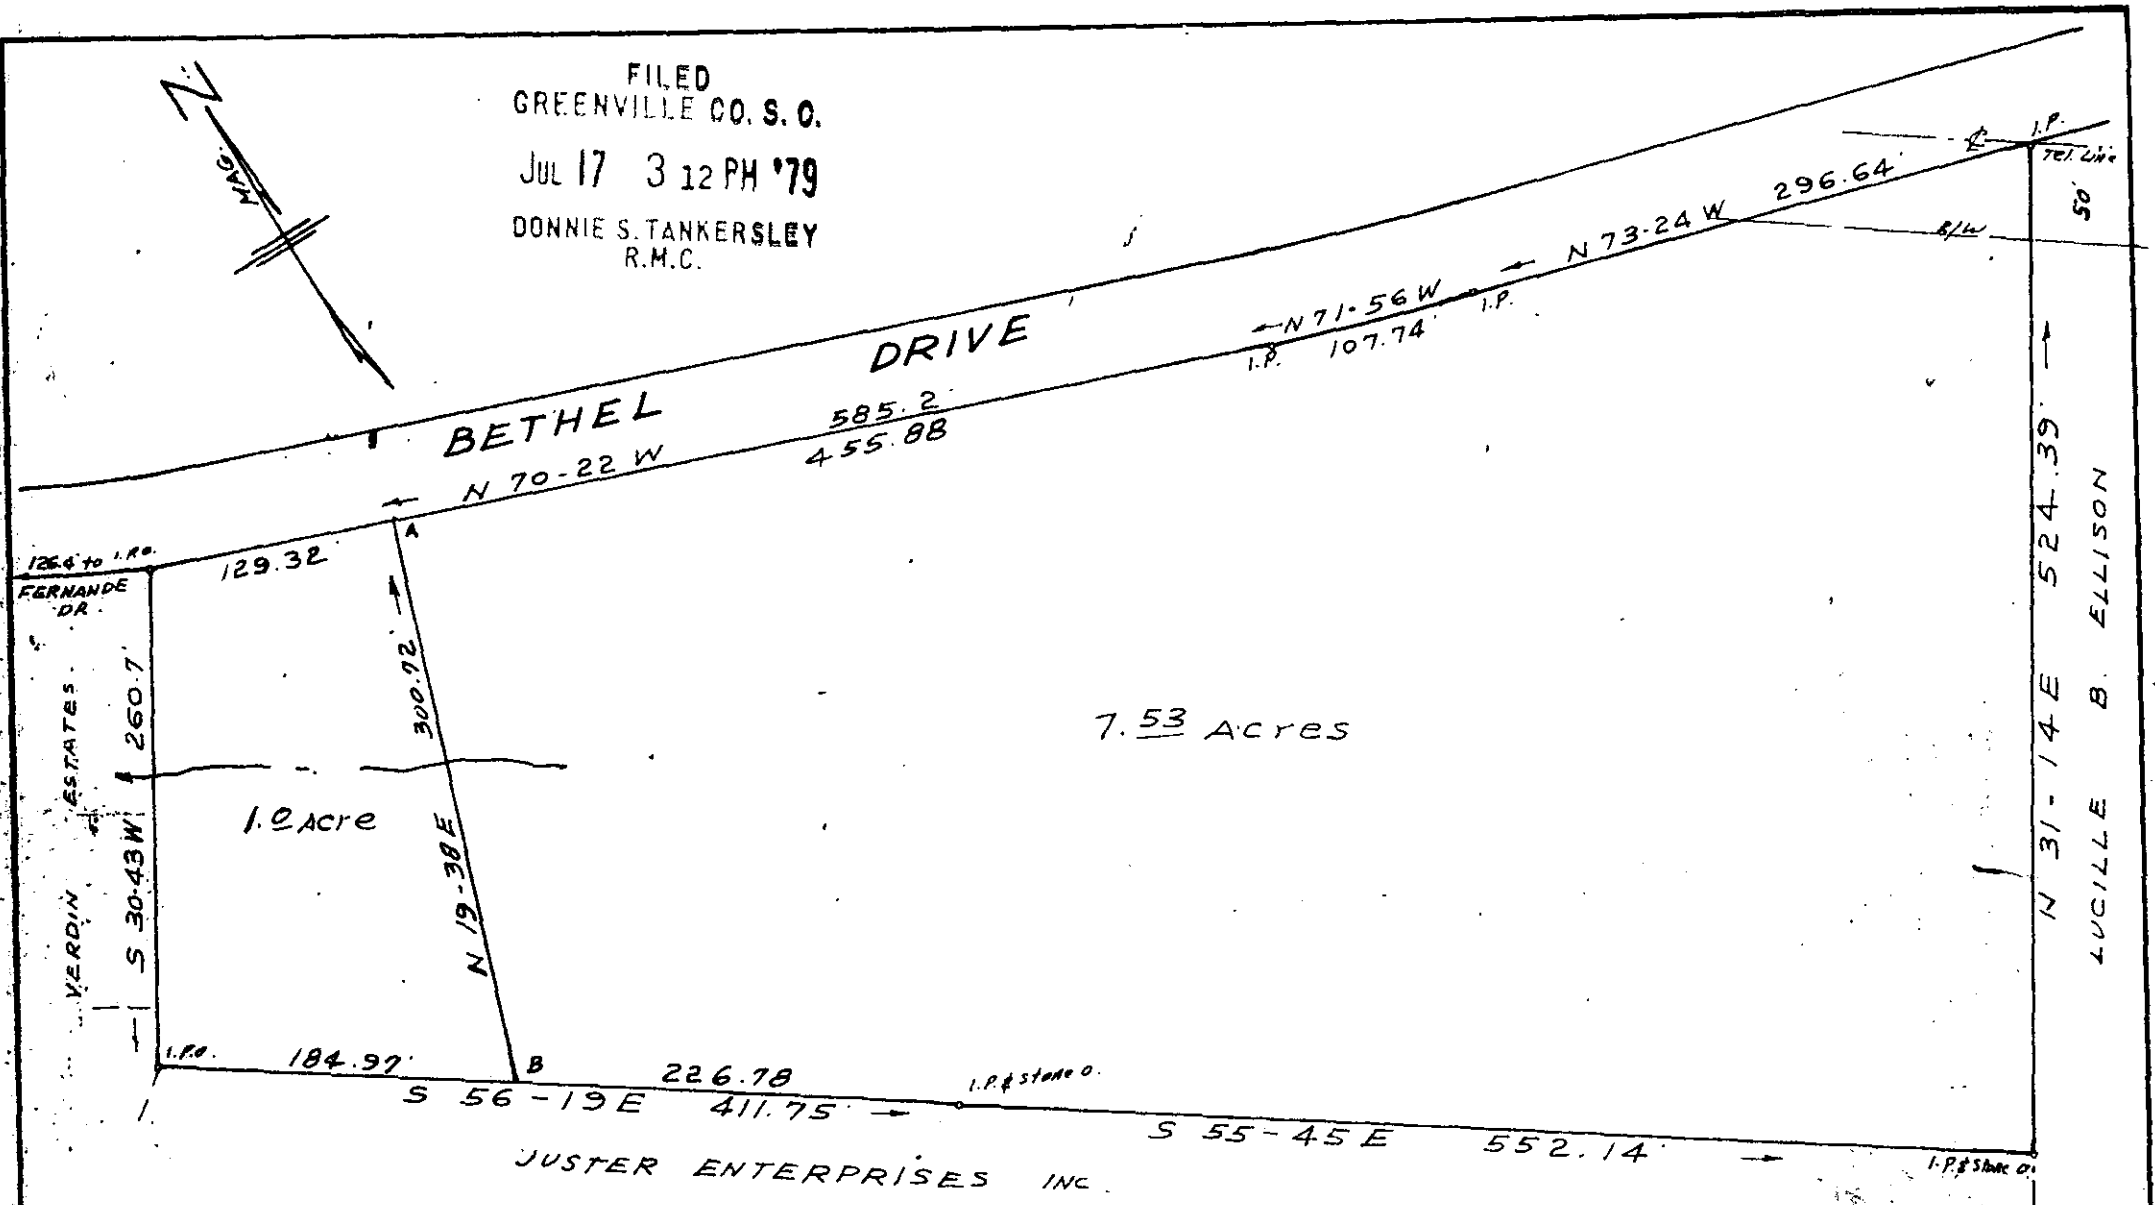


FILED
GREENVILLE CO. S. O.
JUL 17 3 12 PM '79
DONNIE S. TANKERSLEY
R.M.C.

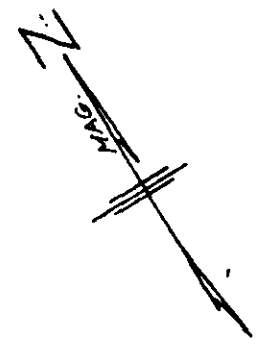

7.53 Acres

JUSTER ENTERPRISES INC.

SURVEY FOR

L. S. GREEN

MAULDIN S. C.

1942

NOTE: LINE A-B COMPUTED AND PLAT REVISED 6/8/79


JUL 17 1979

7-J-57

SCALE 1"=100'

APR. 18, 1978

GCTO -----3 JUL 17 79

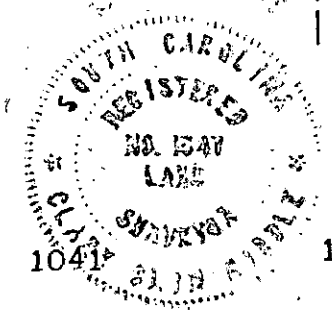

1.000CI

C. O. Riddle - Reg. L.S. 7347

FIELD CLOSURE 1/10/376