


FILED
 GREENVILLE CO. S.C.
 JUL 17 3 12 PM '79
 DONNIE S. TANKERSLEY
 R.M.C.

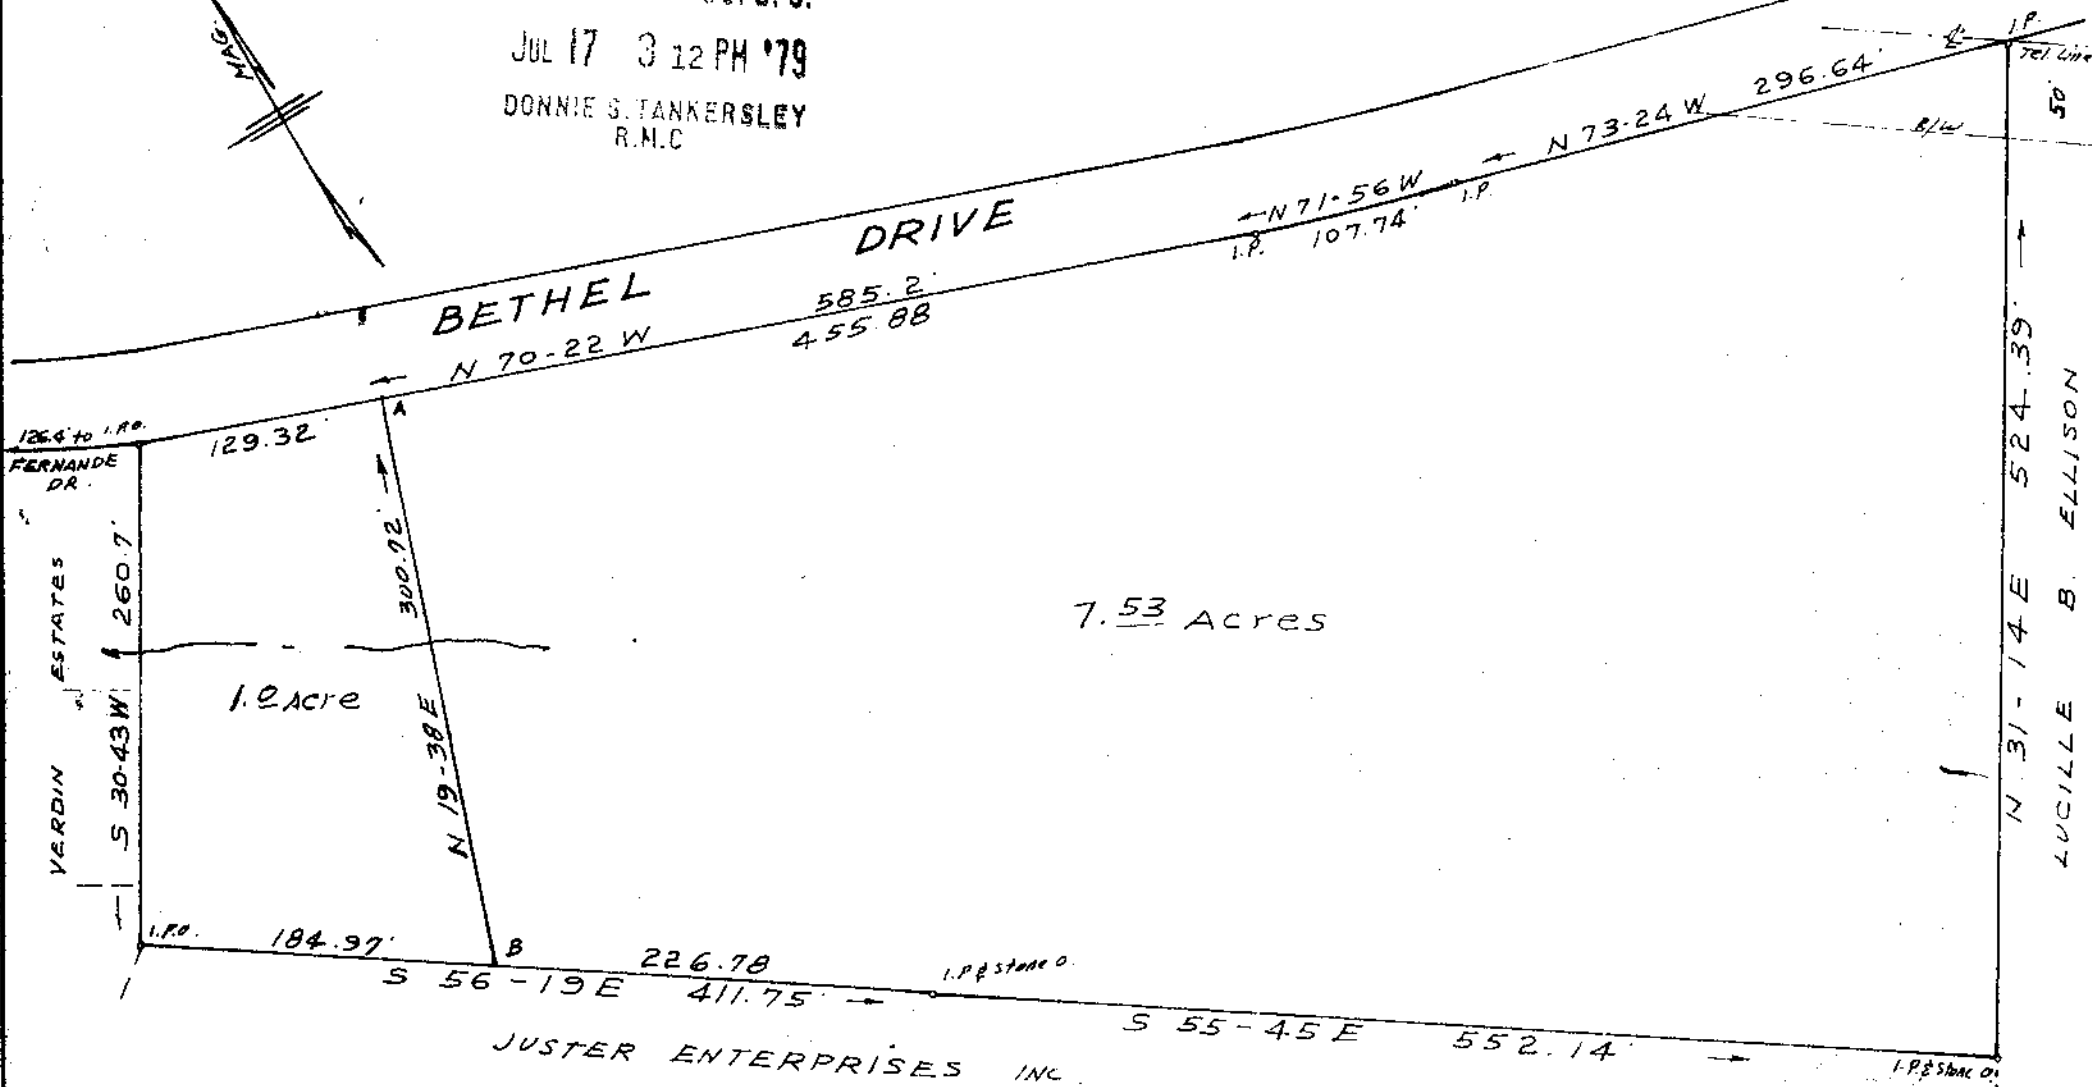

7.53 Acres

1.0 Acre

JUSTER ENTERPRISES INC.

SURVEY FOR
 L. S. GREEN
 MAULDIN S.C.

NOTE: LINE A-B COMPUTED AND PLAT REVISED 6/8/79


JUL 17 1979

7-J-57

SCALE 1"=100'

APR. 18, 1978

GCTO -----3 JUL 17 79

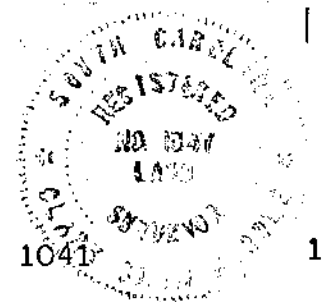

1.000CI

FB, A-78

C. O. Riddle - Rep. L.S. 7347

FIELD CLOSURE 1/10,376

MICROFILMED