MICROFILMED

FILED
GREENVILLE CO. S. C.
JUL 20 4 38 PM '79
DONNIE S. TANKERSLEY
R.M.C.

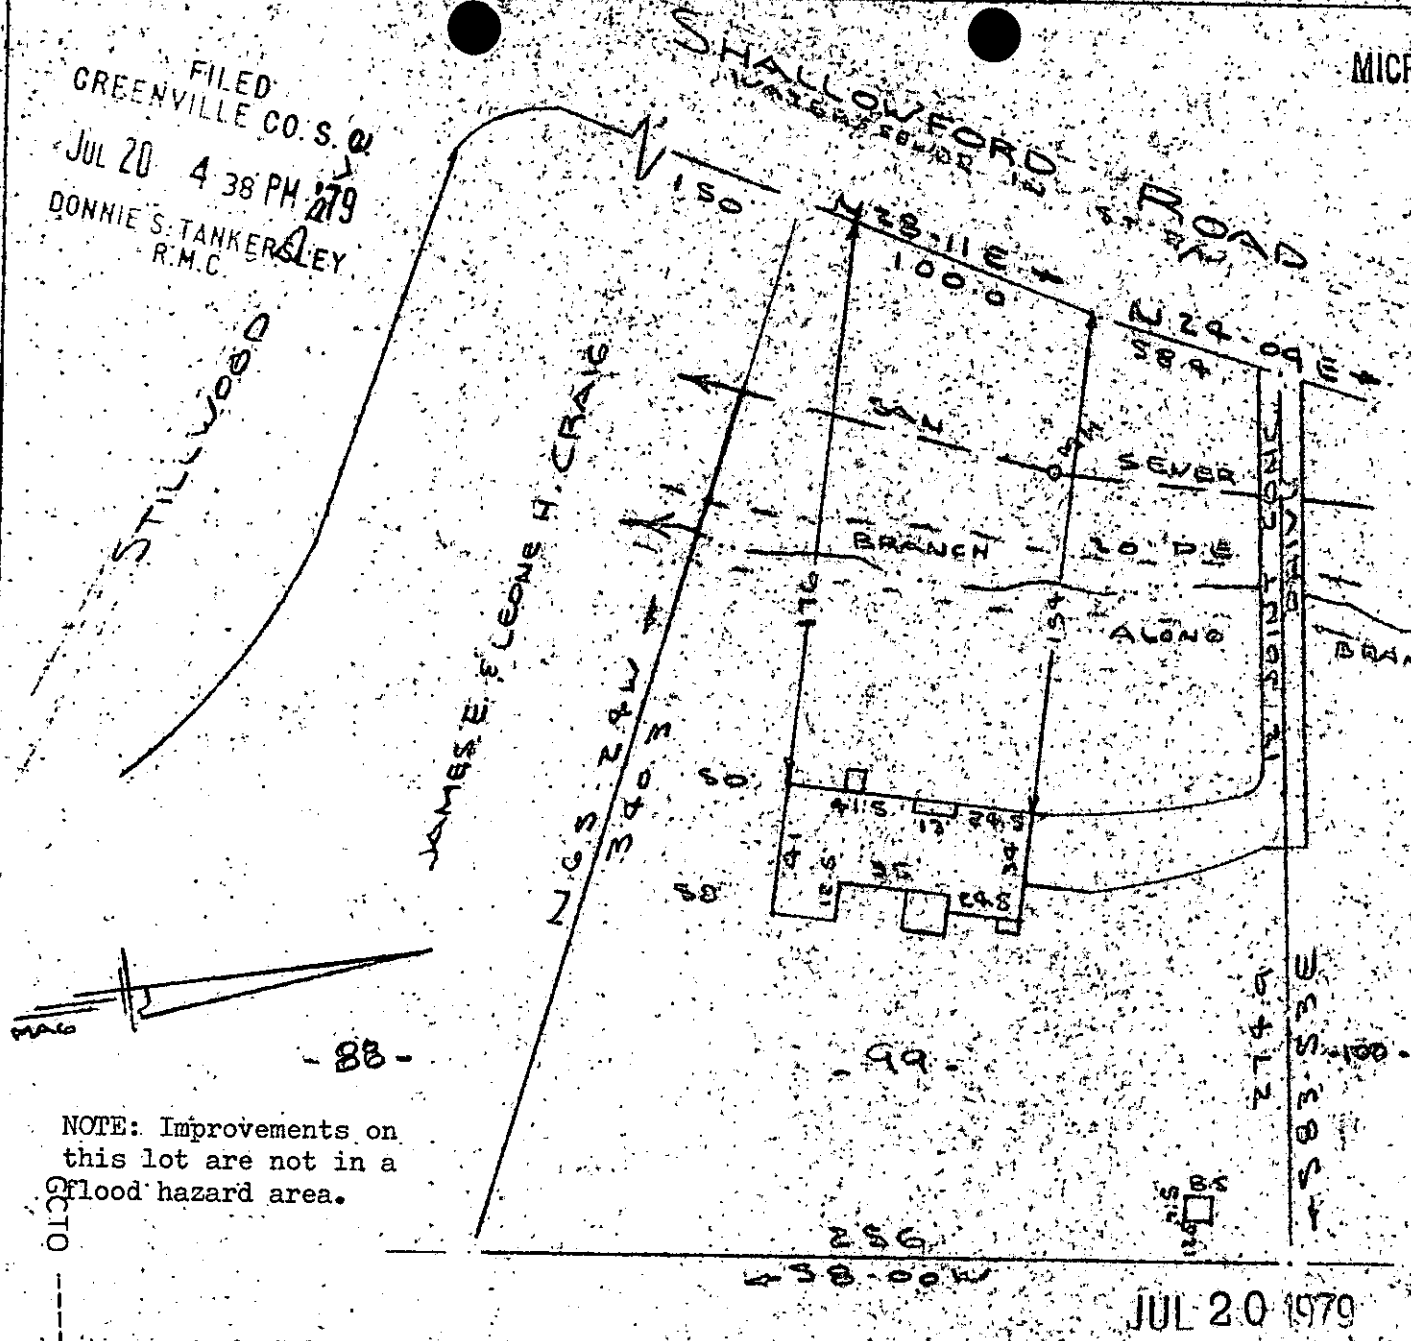

NOTE: Improvements on this lot are not in a flood hazard area.

JUL 20 1979

PROPERTY OF
RICHARD J. EGAN & JANET L. EGAN
NEAR GREENVILLE S.C.
SCALE: 1" = 60' 15 JUNE 1979

This is to certify that on the 15th day of June, 1979, I surveyed the property shown on this plat, being known as lot 99 on plat of ADDITION TO SECTION " F " GOWER ESTATES and recorded in the RMC Office Greenville County, S. C., in Plat Book " RRR " at Page 145; and that the property lines, walls and buildings are as shown hereon, and that the walls and buildings located on said lot do not encroach or project on adjacent street or property, and that no adjacent walls or buildings encroach or project on said premises, and no power lines cross this property except as shown hereon.

7-5-79

R. B. Bruce

R. B. Bruce, RLS #1952

2387

CAROLINA SURVEYING CO.
112 Manly St.
Greenville, S. C.

GCTO ----3 JL20 79

1.00CI

2C8.2-C-8