


FILED
GREENVILLE CO. S. C.

JUL 24 4 52 PM '79

DONNIE S. TANKERSLEY
R.M.C.

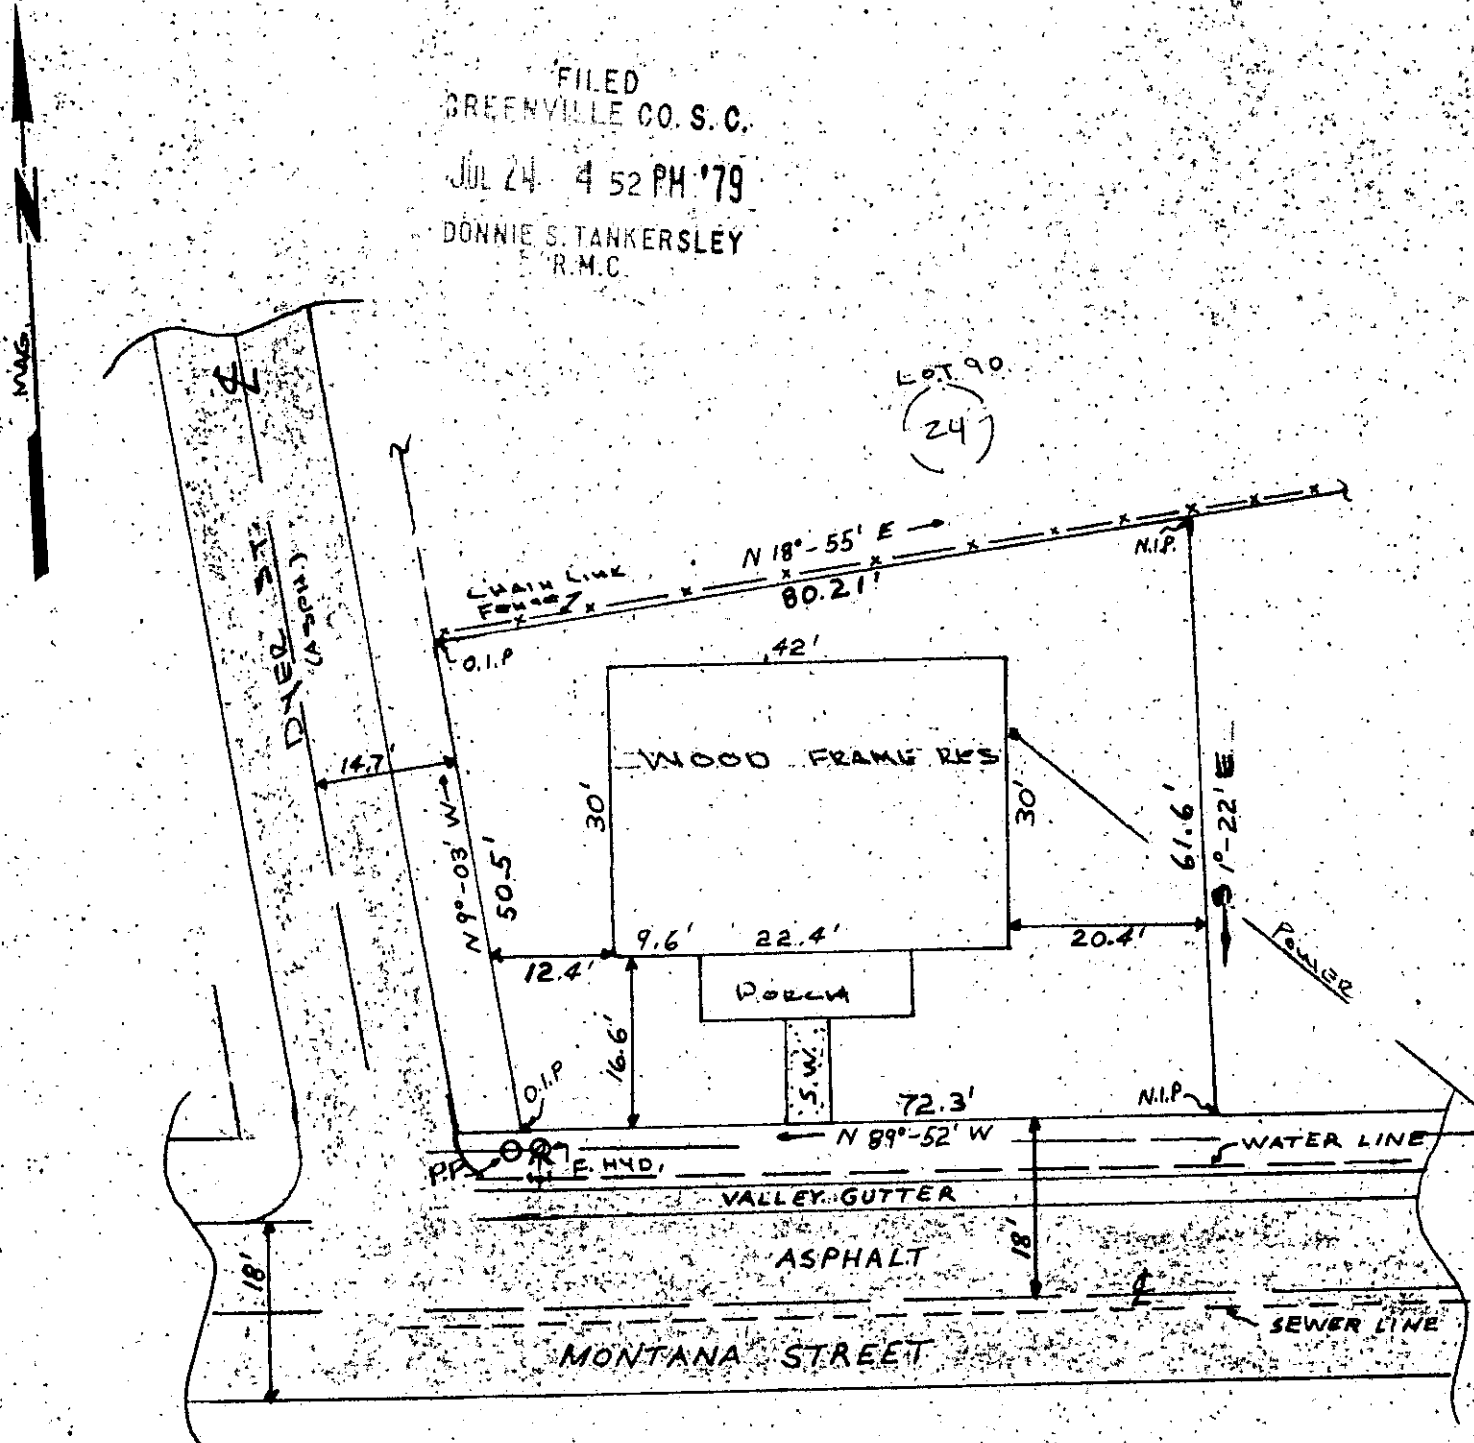


GCHD
3 JUL 24 1979
1566

CERTIFY THE ABOVE TRACT WAS RESEX
SURVEYED AND LOT 89, MORGAN HILL SUB-
DIVISION, DIVIDED AS SHOWN.

MORGAN HILL SUB DIVISION

REF. INFO. DEED BK. 979 PG. 139, PLT. BK. A PAGE 170
BLK. BK. 54. 136-7-23

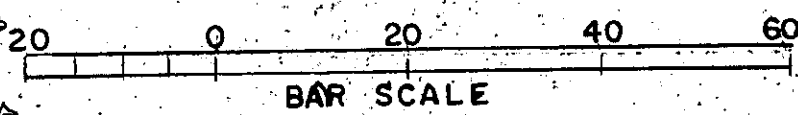

ABOVE PROPERTY IS NOT IN A
FLOOD PLAIN.
NO ENCROACHMENT

Herbert T. Gould
S.C. REG. NO 4035

JUL 24 1979

Seal: **7-J-90**

HERBERT T. GOULD
REGISTERED LAND SURVEYOR
NO. 4035
STATE OF SOUTH CAROLINA

2713 PROPERTY OF
ALVIN H. & DOROTHY E. SOUTHERLIN
GOULD & ASSOC
SURVEYORS
TAYLORS, S. C.

Drawn By N.D.G.
Checked By K.T.G.
Scale 1" = 20'
Date 7-20-79
File No.
Dwg. No.