


FILED  
GREENVILLE CO. S. C.  
JUL 25 11 32 AM '79

CAROLINE STREET  
WATER & SEWER IN ST ROW

DONNIE S. TANKERSLEY  
R.M.C.

STAUNTON DR. RD

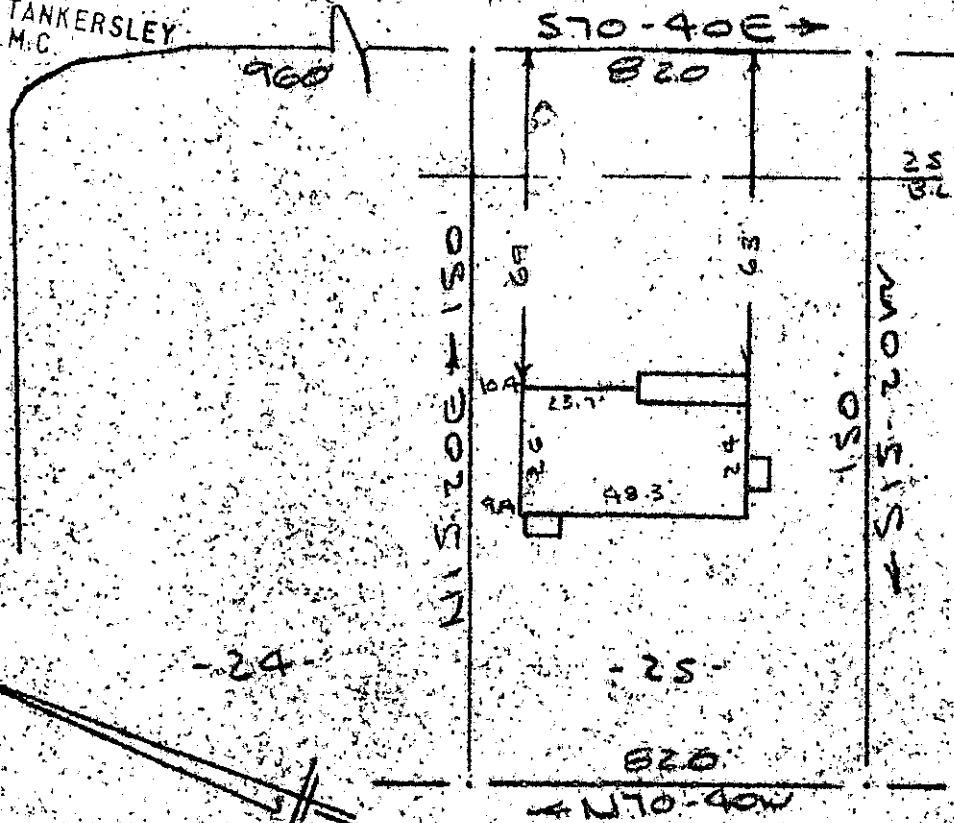

NOTE: Improvements on this lot are not in a flood hazard area.

- ELIZABETH HGT -

JUL 25 1979

PROPERTY OF  
JEFFERY A. LYLES & ELAINE D. LYLES  
NEAR GREENVILLE, SC  
SCALE 1" = 40' 25 JULY 1979

This is to certify that on the 25th day of July, 1979, I surveyed the property shown on this plat, being known as lot 25 on plat of OXFORD ESTATES and recorded in the REC Office Greenville County, S. C., in Plat Book "W" at Page 158; and that the property lines, walls and buildings are as shown hereon, and that the walls and buildings located on said lot do not encroach or project on adjacent street or property, and that no adjacent walls or buildings encroach or project on said premises, and no power lines cross this property except as shown hereon. Also being known as PROPERTY OF JEFFERY A. LYLES & ELAINE D. LYLES and recorded in Plat Book at Page

25 - 91

H. B. Bruce, DLS 1952

CAROLINA SURVEYING CO.  
112 Manly St.  
Greenville, S. C.

2759

1.0001