FILED
GREENVILLE CO. S. C.
JUL 27 4 38 PM '79
DONNIE S. TANKERSLEY
R.M.C.

MICROFILMED

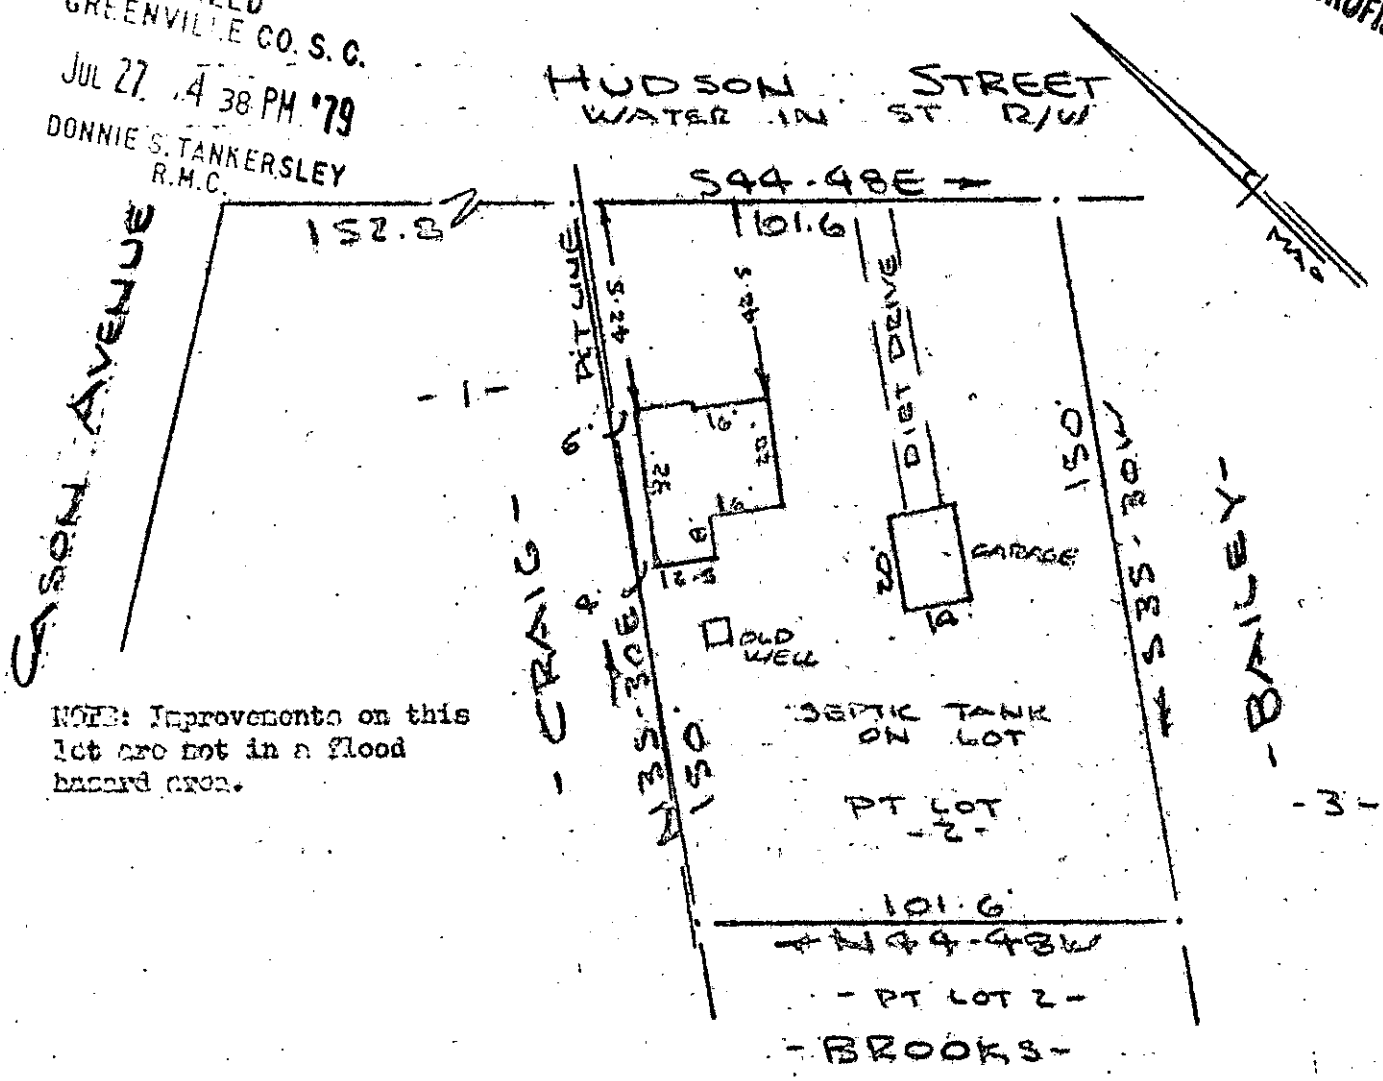

NOTE: Improvements on this lot are not in a flood hazard area.

JUL 27 1979

PROPERTY OF

GEORGE R. RANDOLPH

NEAR GREENVILLE S.C.

SCALE 1"=40 16 JULY 1979

This is to certify that on the 16th day of July, 1979, I surveyed the property shown on this plat, being known as part of lot 2 on plat of PIEDMONT PARK (THOMAS W. BUTLER PROPERTY) and recorded in the RMC Office Greenville County, S. C., in Plat Book " T " at Page 221; and that the property lines, walls and buildings are as shown hereon, and that the walls and buildings located on said lot do not encroach or project on adjacent street or property, and that no adjacent walls or buildings encroach or project on said premises, and no power lines cross this property except as shown hereon.

3245

R. B. Bruce

R. B. Bruce, RLS 1952

2-K-6

CAROLINA SURVEYING CO.
112 Manly St.
Greenville, S. C.

GCTO ----- 3 JL27 79 470

1.00CI