


MICROFILMED

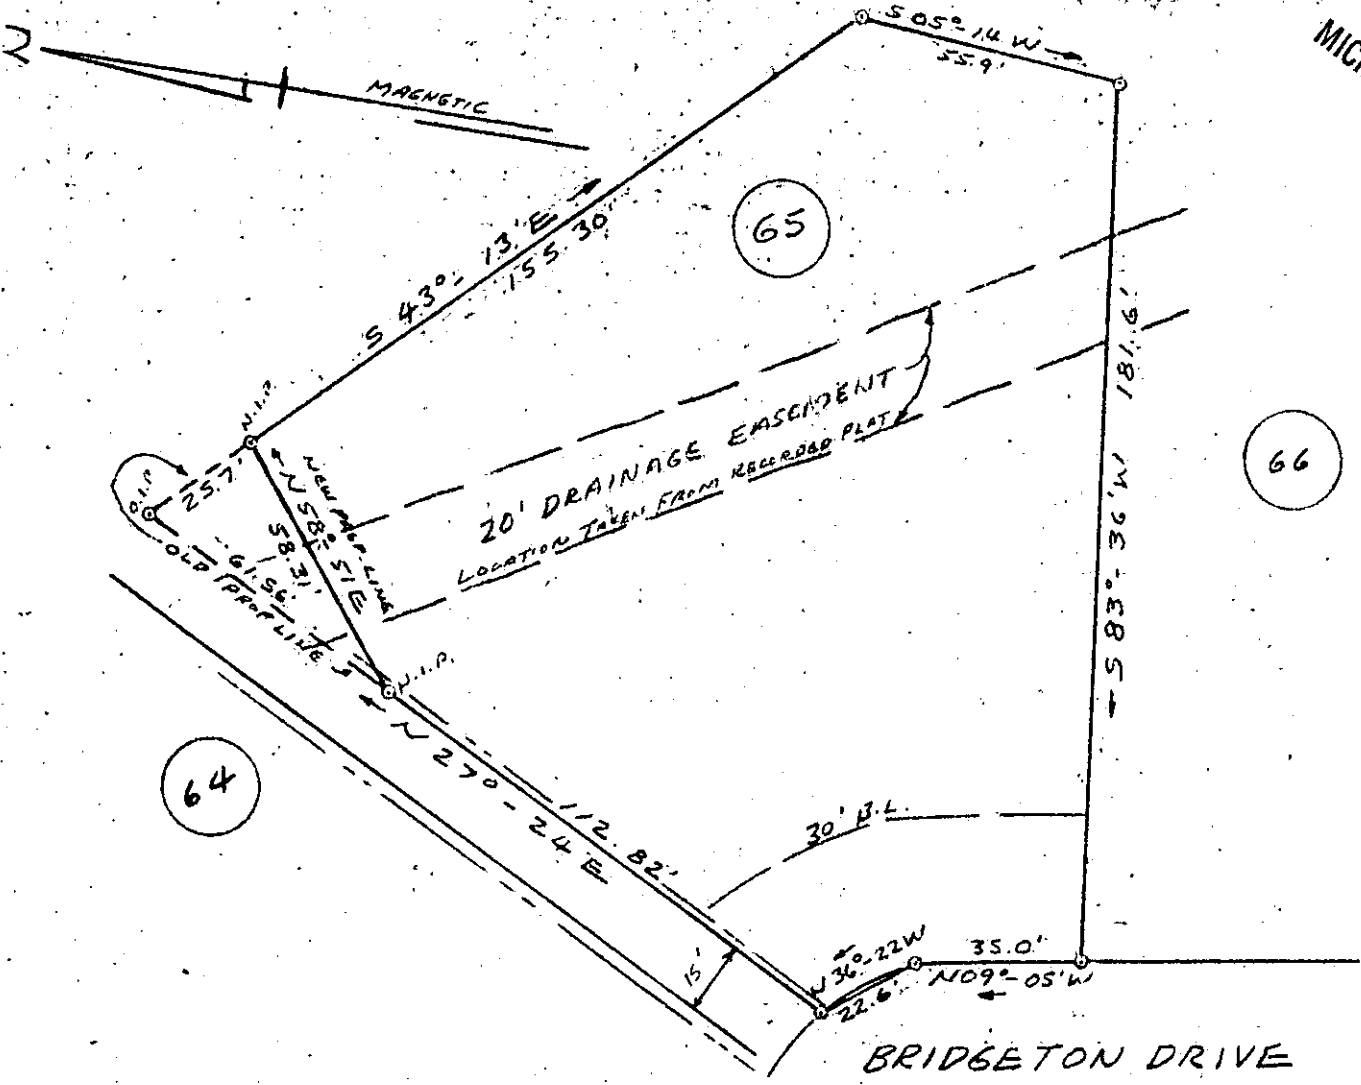

REVISION OF

LOT No. 65 STRATTON PLACE SHEET 2 OF 2

GREENVILLE, SOUTH CAR.

JULY 13, 1979 SCALE: 1"=40'

FILED IN GREENVILLE CO. S.C.
JUL 31 4 24 PM '79
DONNIE S. TANKERSLEY
R.M.C.

3727

7K-21 ✓

SURVEY BY: RICHARD D. VOOTEN, JR.
Richard D. Vooten, Jr.

S.C. REG. NO. 4628

D. VOOTEN, JR.
SURVEYOR

JUL 31 1979

GCTD 3 JUL 31 79 686

1.00CI