MICROFILMED

FILED
GREENVILLE CO. S. C.
OCT 26 11 19 AM '79
DONNIE S. TANKERSLEY
R.M.C

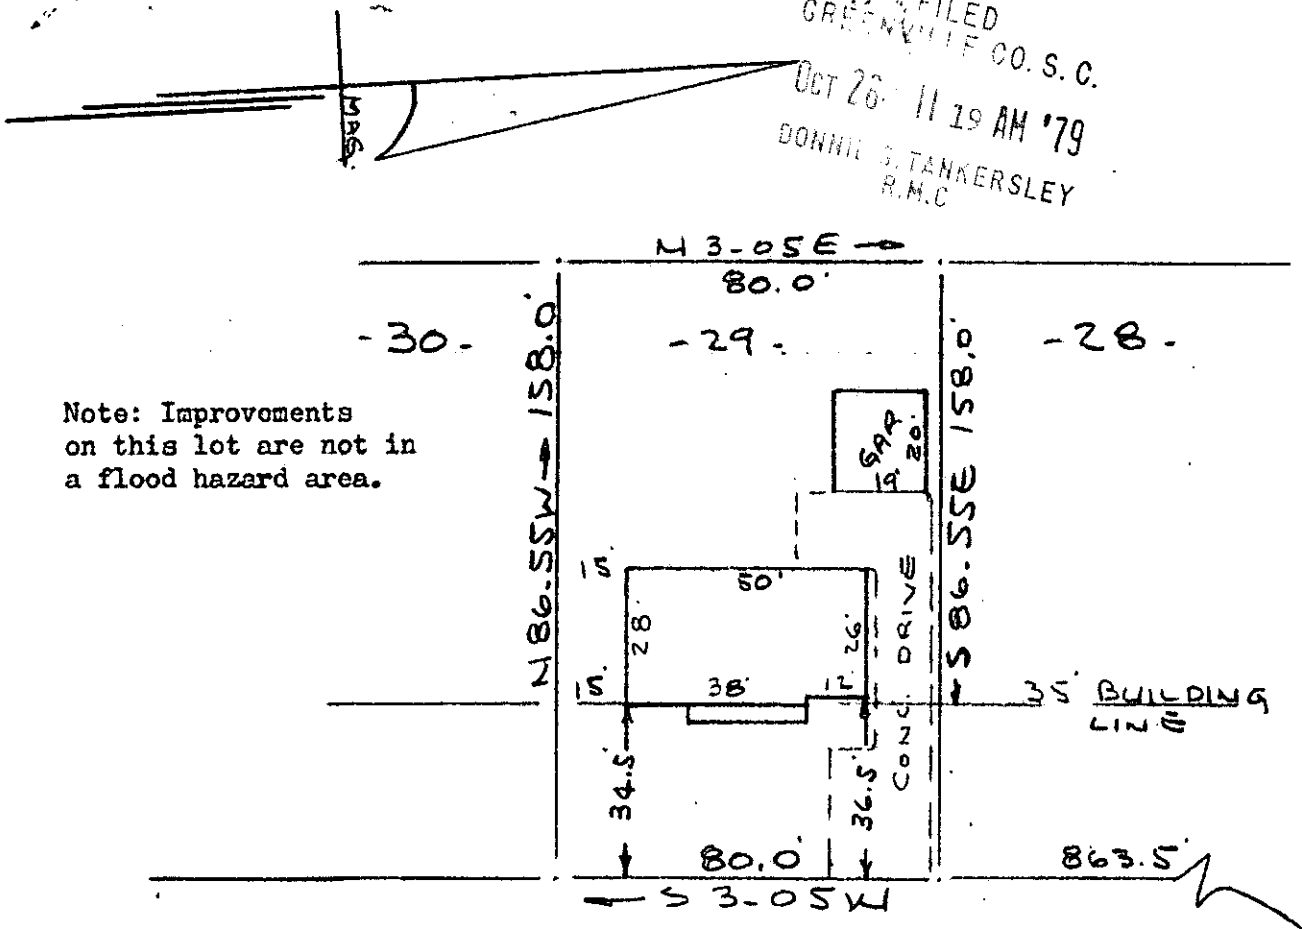

Note: Improvements on this lot are not in a flood hazard area.

PROPERTY OF
JOHN THOMAS OWENS & NANCY JO OWENS
NEAR GREENVILLE, S.C.

SCALE 1" = 40' 22 OCT 1979

This is to certify that on the 22nd day of October, 1979, I surveyed the property shown on this plat, being known as lot 29 on plat of BLUE BERRY PARK and recorded in the RMC Office Greenville County, S. C., in Plat Book " BB " at Page 18; and that the property lines, walls and buildings are as shown hereon, and that the walls and buildings located on said lot do not encroach or project on adjacent street or property, and that no adjacent walls or buildings encroach or project on said premises, and no power lines cross this property except as shown hereon.

✓ 7-K-31 14051

R. B. Bruce

R. B. Bruce, RLS #1952

OCT 26 1979

CAROLINA SURVEYING CO.
112 Manly St.
Greenville, S. C.

GCTC
1 OCT 79
3.00CI