MICROFILMED

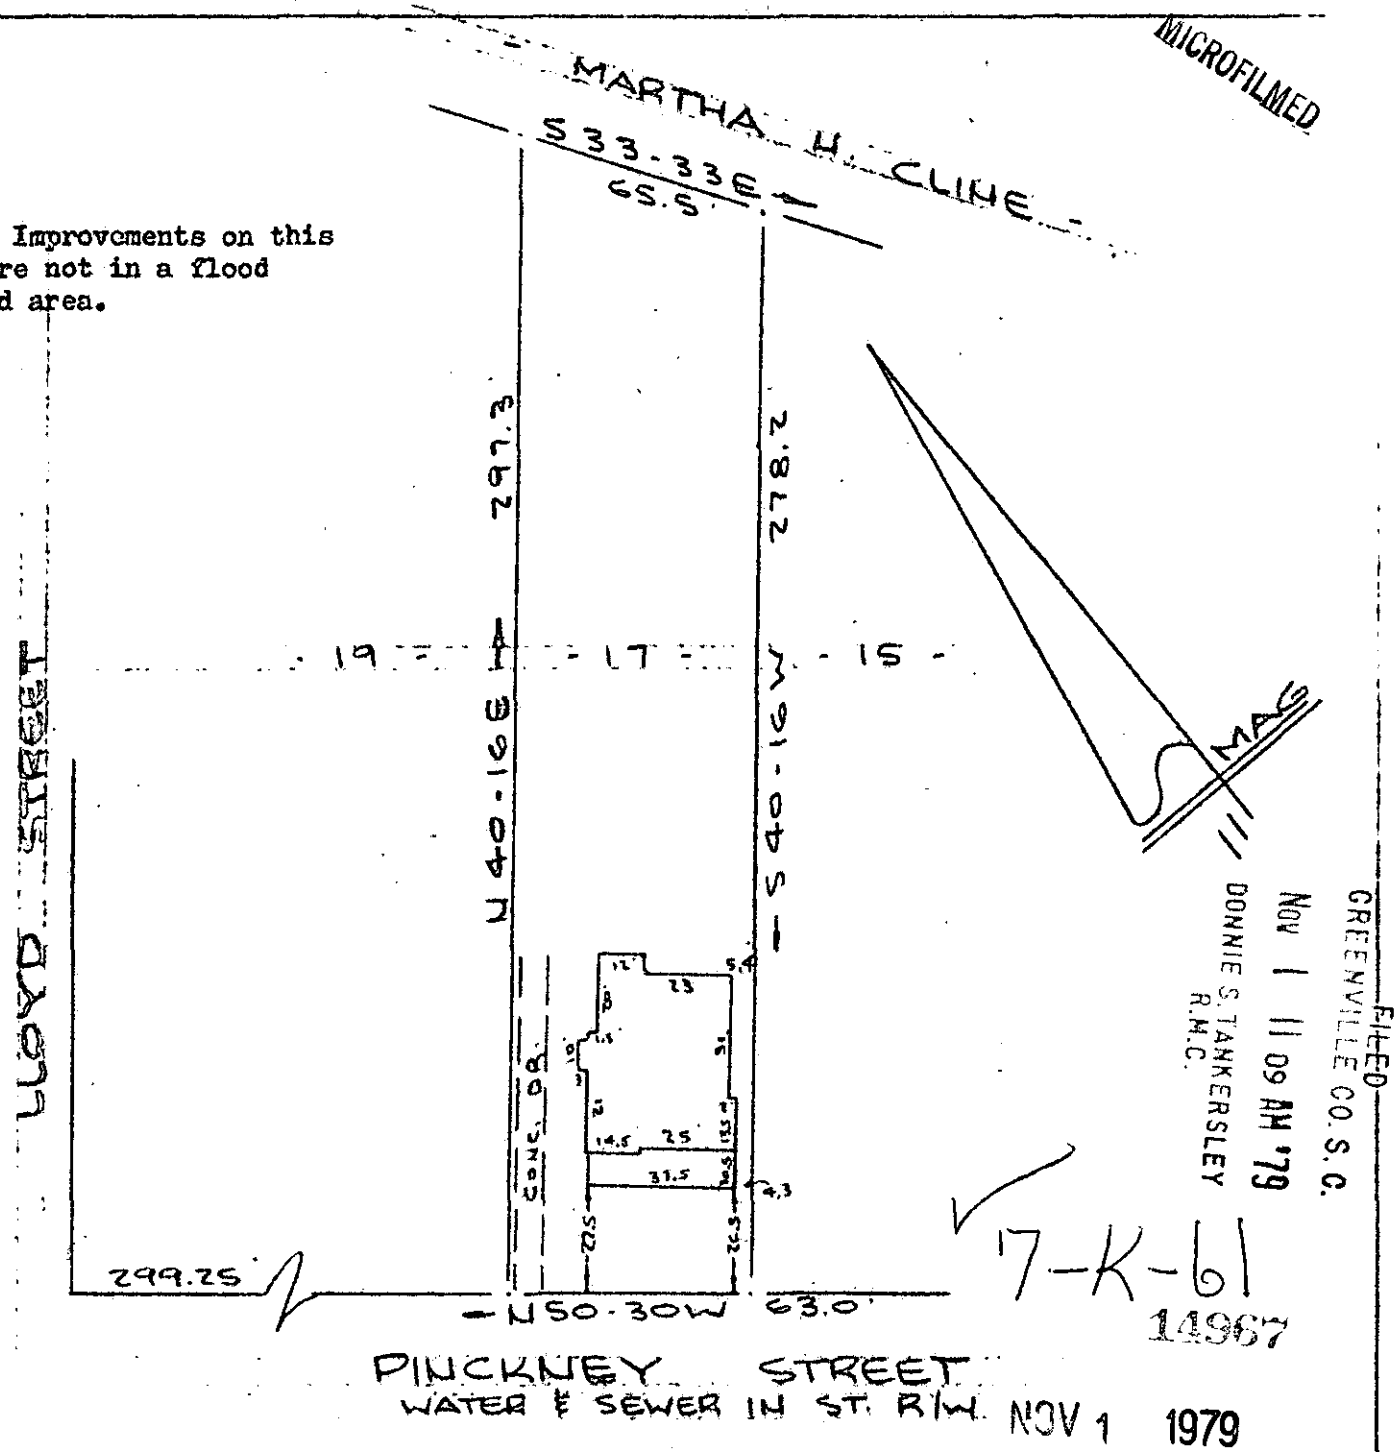

- Note: Improvements on this lot are not in a flood hazard area.

PROPERTY OF

GENE E. DEAMICIS & TERRY I. DEAMICIS

GREENVILLE, SOUTH CAROLINA

SCALE: 1" = 50' 31OCT1979

This is to certify that on the 31st day of October, 1979, I surveyed the property shown on this plat, being known as lot 17 on plat of PROPERTY OF GENE E. DeAMICIS & TERRY I. DeAMICIS and recorded in the RMC Office Greenville County, S. C. in Plat Book at Page ; and that the property lines, walls and buildings are as shown hereon, and that the walls and buildings are as shown hereon, and that the walls and buildings located on said lot do not encroach or project on adjacent street or property, and that no adjacent walls or buildings encroach or project on said premises, and no power lines cross this property except as shown hereon.

R. B. Bruce

CAROLINA SURVEYING CO. R. B. Bruce, RLS #1952

112 Manly St., Greenville, S. C.

212/13-A 19-1-180 1 8E 7W 1E 3.00 A4