

MICROFILMED

MAG. NORTH



This is to certify that on October 29, 1979, I surveyed the property shown on this plat, known as Lot 5 on plat of John H. Houston Property, recorded in the RMC Office of Greenville County in Plat Book VV on page 264, and that the property lines, walls and buildings are as shown hereon; that the building located on said lot does not encroach or project on adjacent streets or property, and that no adjacent walls or buildings encroach or project on said premises, and that no utility lines cross this property except as shown hereon. This property is not located in a designated flood hazard area.

James R. Freeland
 James R. Freeland RLS & PE 4781

FILED
 GREENVILLE CO. S.C.
 NOV 1 3 30 PM '79
 DONNIE S. TANKERSLEY
 R.M.C.

NOV 1 1979

✓ 7K-67

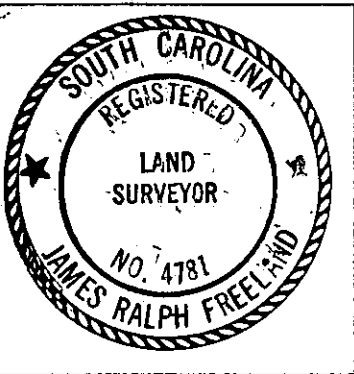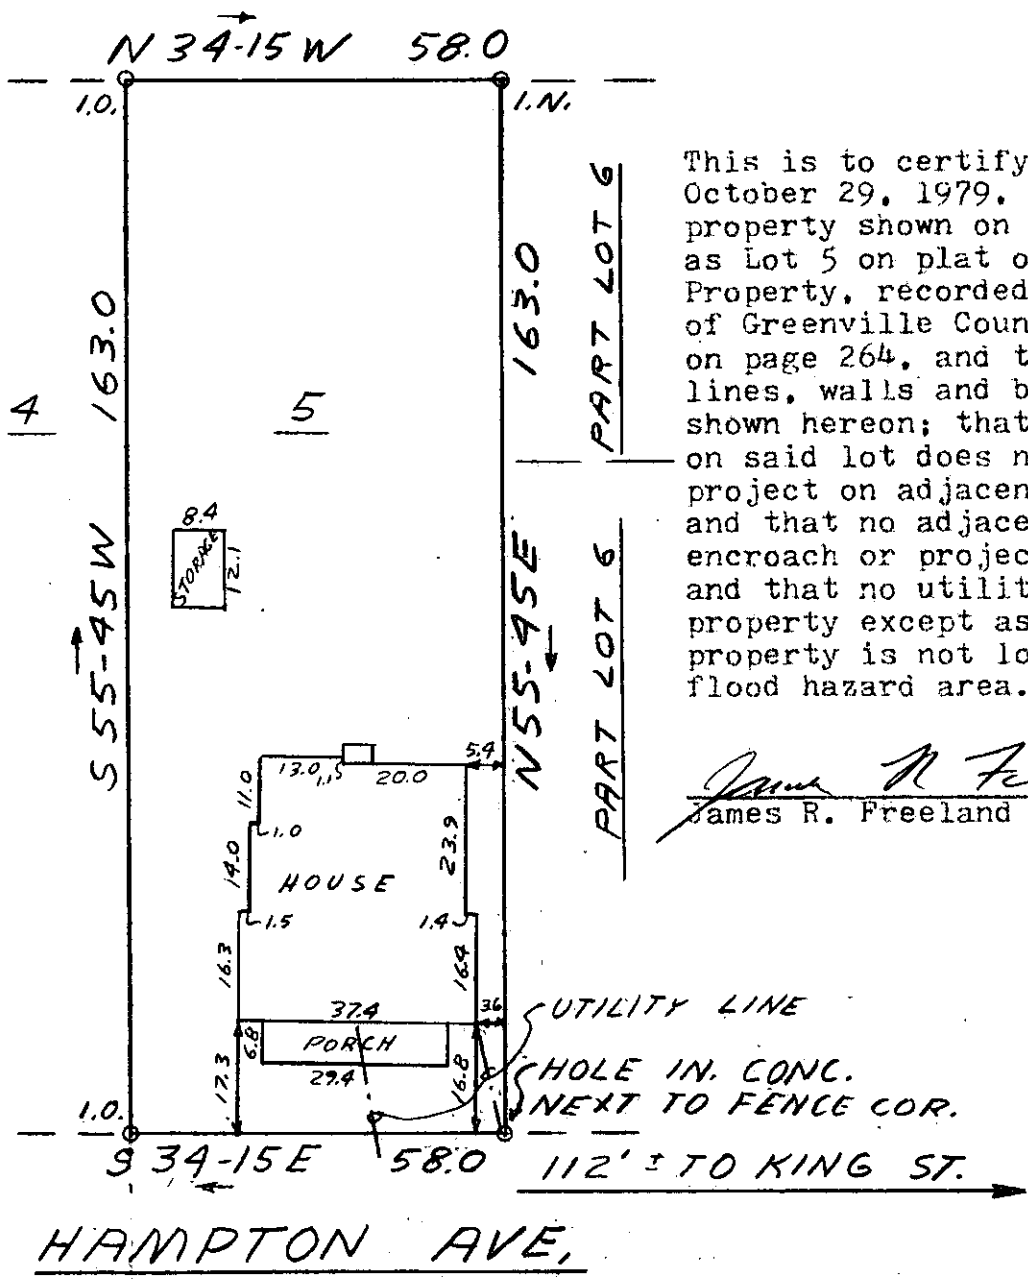

STATE OF SOUTH CAROLINA
 GREENVILLE COUNTY

PROPERTY OF
PAUL M. CRANE

FREELAND & ASSOCIATES
 Engineers • Land Surveyors

GREENVILLE, S.C.

SURVEY	BH
DRAWN	JRF
CHECK	MC
SCALE	1" = 30'
DATE	10-29-79
DWG. NO.	79-4372