


MICROFILMED

TARA AVENUE

WATER & SEWER IN ST R/W

S 84.40 E

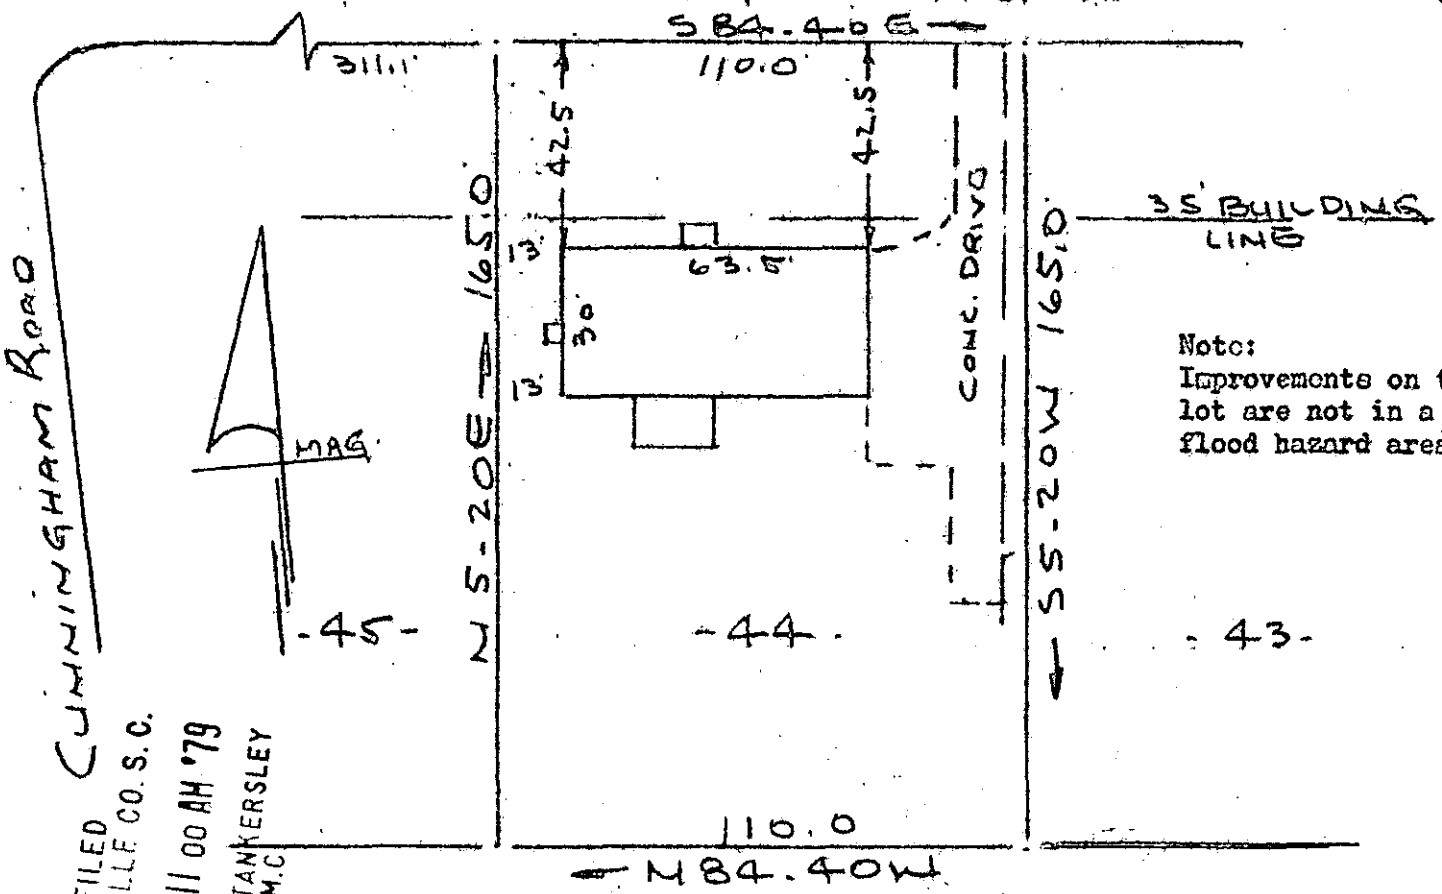

CUMMINGHAM ROAD

FILED
GREENVILLE CO. S.C.
NOV 2 11 00 AM '79
DONNIE S. TANKERSLEY
R.M.C.

PROPERTY OF
DRESTON WALKER GARRISON & JOAN G. GARRISON
NEAR GREENVILLE, S.C.
SCALE 1" = 40' 1 NOV 1979

This is to certify that on the 1st day of November, 1979, I surveyed the property shown on this plat, being known as lot 44 on plat of MAP NO. ONE CUMMINGHAM ACRES and recorded in the RMC Office Greenville County, S. C., in Plat Book "BBB" at page 118; and that the property lines, walls and buildings are as shown hereon, and that the walls and buildings located on said lot do not encroach or project on adjacent street or property, and that no adjacent walls or buildings encroach or project on said premises, and no power lines cross this property except as shown hereon.

7K-70

NOV 2 1979

R. B. Brubaker
R. B. Brubaker, RLS 71852

CAROLINA SURVEYING CO.
112 Manly St.
Greenville, S. C.

15047

3.0001

211@71

S3A.3-1-191