


MICROFILMED

PERRY AVENUE  
WATER & SEWER IN ST B/W  
569-29E

ACADEMY STREET  
437

FILED  
GREENVILLE CO. S. C.  
NOV 7 4 40 PM '79  
DONNIE S. TANKERSLEY  
R.M.C.

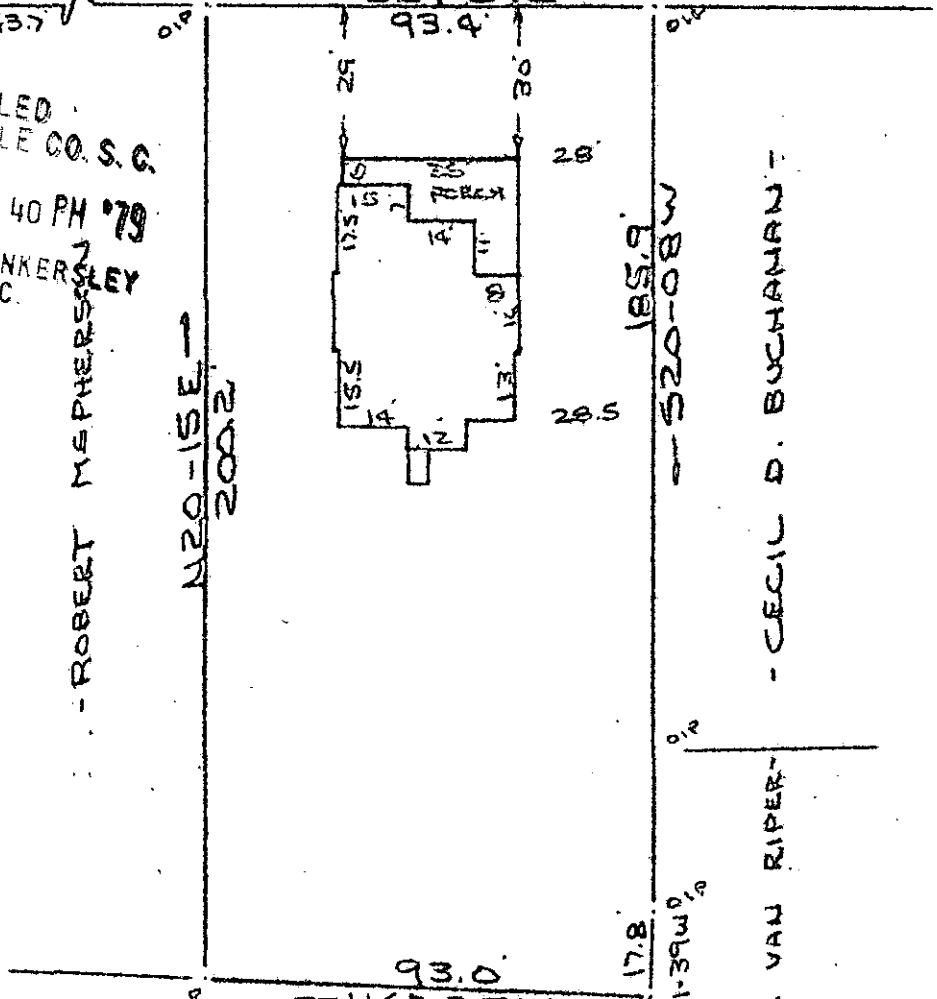

- ROBERT McPHERSON -

N20-15E-  
2002

185.9  
- S20-08W

- CECIL D. BUCHANAN -

17.8  
- S21-39W 1/2  
- WARREN VAN RIVER -

93.0  
- N67-25W  
- JULIAN HARMON -

NOV 7 1979

7-K-86

PROPERTY OF  
EDDIE W. BOOKER  
GREENVILLE, S.C.  
SCALE: 1" = 40' 20 OCT 1979

15706

Note:  
Improvements on  
this lot are not  
in a flood hazard  
area.

GCTO --- I NO 7  
3.0001

This is to certify that on the 30th day of October, 1979, I surveyed the property shown on this plat, being known as PROPERTY OF EDDIE W. BOOKER and recorded in the REC Office Greenville County, S. C., in Plat Book at Page ; and that the property lines, walls and buildings are as shown hereon, and that the walls and buildings located on said lot do not encroach or project on adjacent street or property, and that no adjacent walls or buildings encroach or project on said premises, and no power lines cross this property except as shown hereon.

R. B. Bruce  
R. B. Bruce, RL 11952

CAROLINA SURVEYING CO.  
112 Manly St., Greenville, S. C.