AF 10505

MICROFILMED

FILED
GREENVILLE CO. S.C.
NOV 9 10 32 AM '79
DONNIE S. TANKERSLEY
R.M.C.

15876

7-K-95

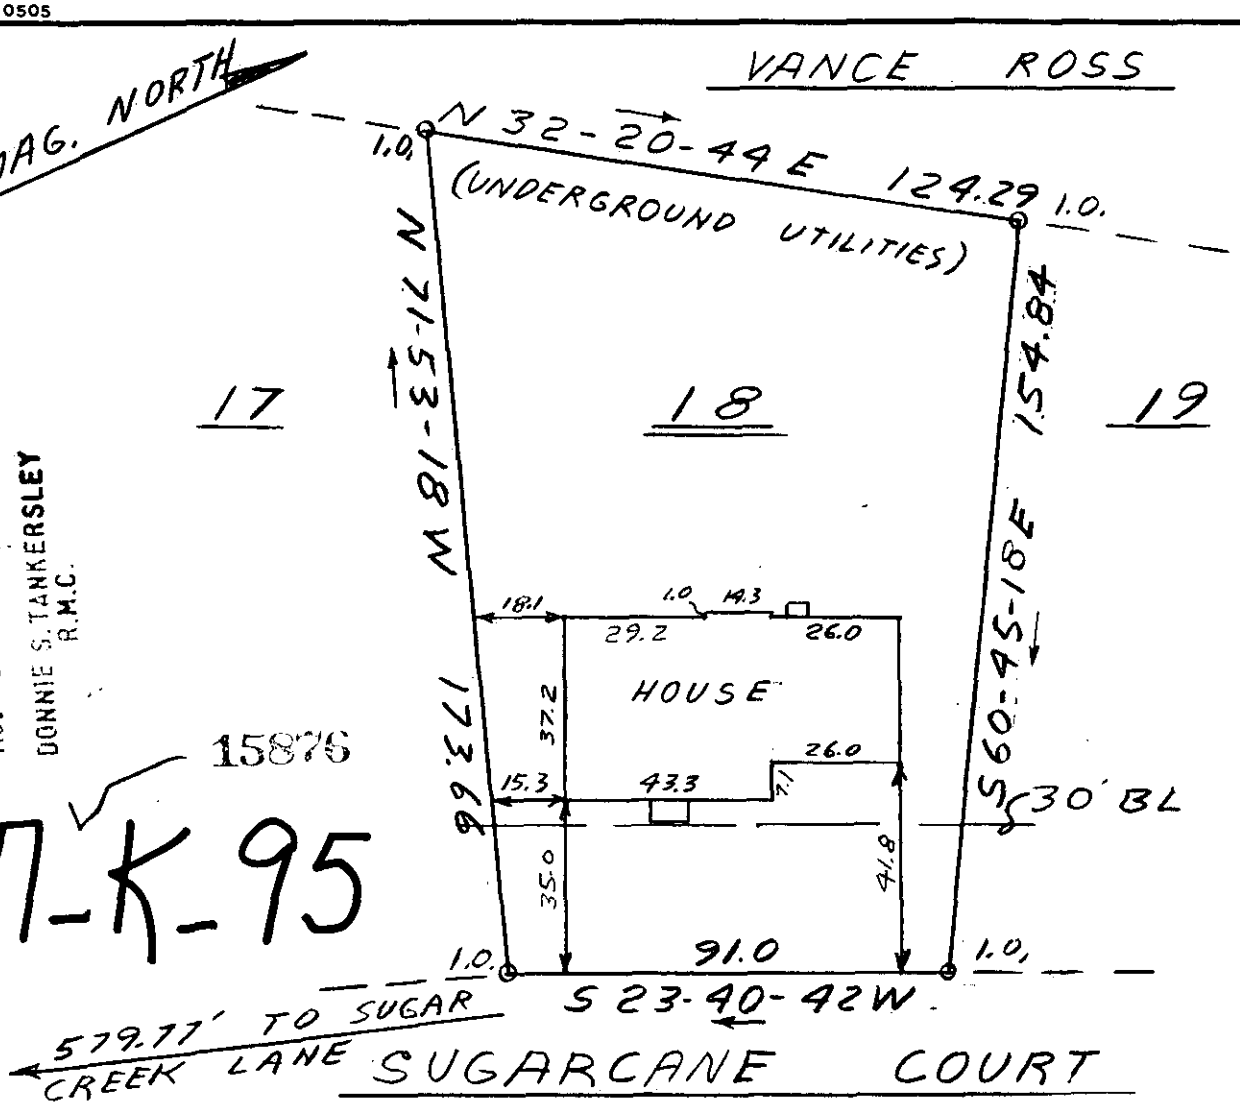

This is to certify that on October 31, 1979, I surveyed the property shown on this plat, known as Lot 18 on plat of Sugar Creek Map 7, recorded in the RMC Office of Greenville County in Plat Book 7C on page 15, and that the property lines, walls and buildings are as shown hereon; that the building located on said lot does not encroach or project on adjacent streets or property, and that no adjacent walls or buildings encroach or project on said premises, and that no utility lines cross this property except as shown hereon. This property is not located in a designated flood hazard area.

Drainage and utilities easement 5' each side of all side and rear lot lines.

40 0 40 80

James R. Freeland
James R. Freeland RLS & PE 4781

SOUTH CAROLINA REGISTERED LAND SURVEYOR NO. 4781 JAMES RALPH FREELAND

SEAL

STATE OF SOUTH CAROLINA
GREENVILLE COUNTY

SUGAR CREEK
MAP NO. 7 - LOT 18
PROPERTY OF
CHARLES H. ENGLISH JR.
JO ANN ENGLISH

FREELAND & ASSOCIATES
Engineers • Land Surveyors
GREENVILLE, S.C.

SURVEY	VB
DRAWN	JRF
CHECK	MC
SCALE	1" = 40'
DATE	10-31-79
DWG. NO.	79-4352

3 2 7 5 "V 9E 3.00 A4