


SEP 5 2 57 PM '79

DONNIE S. TANKERSLEY
R.M.C.

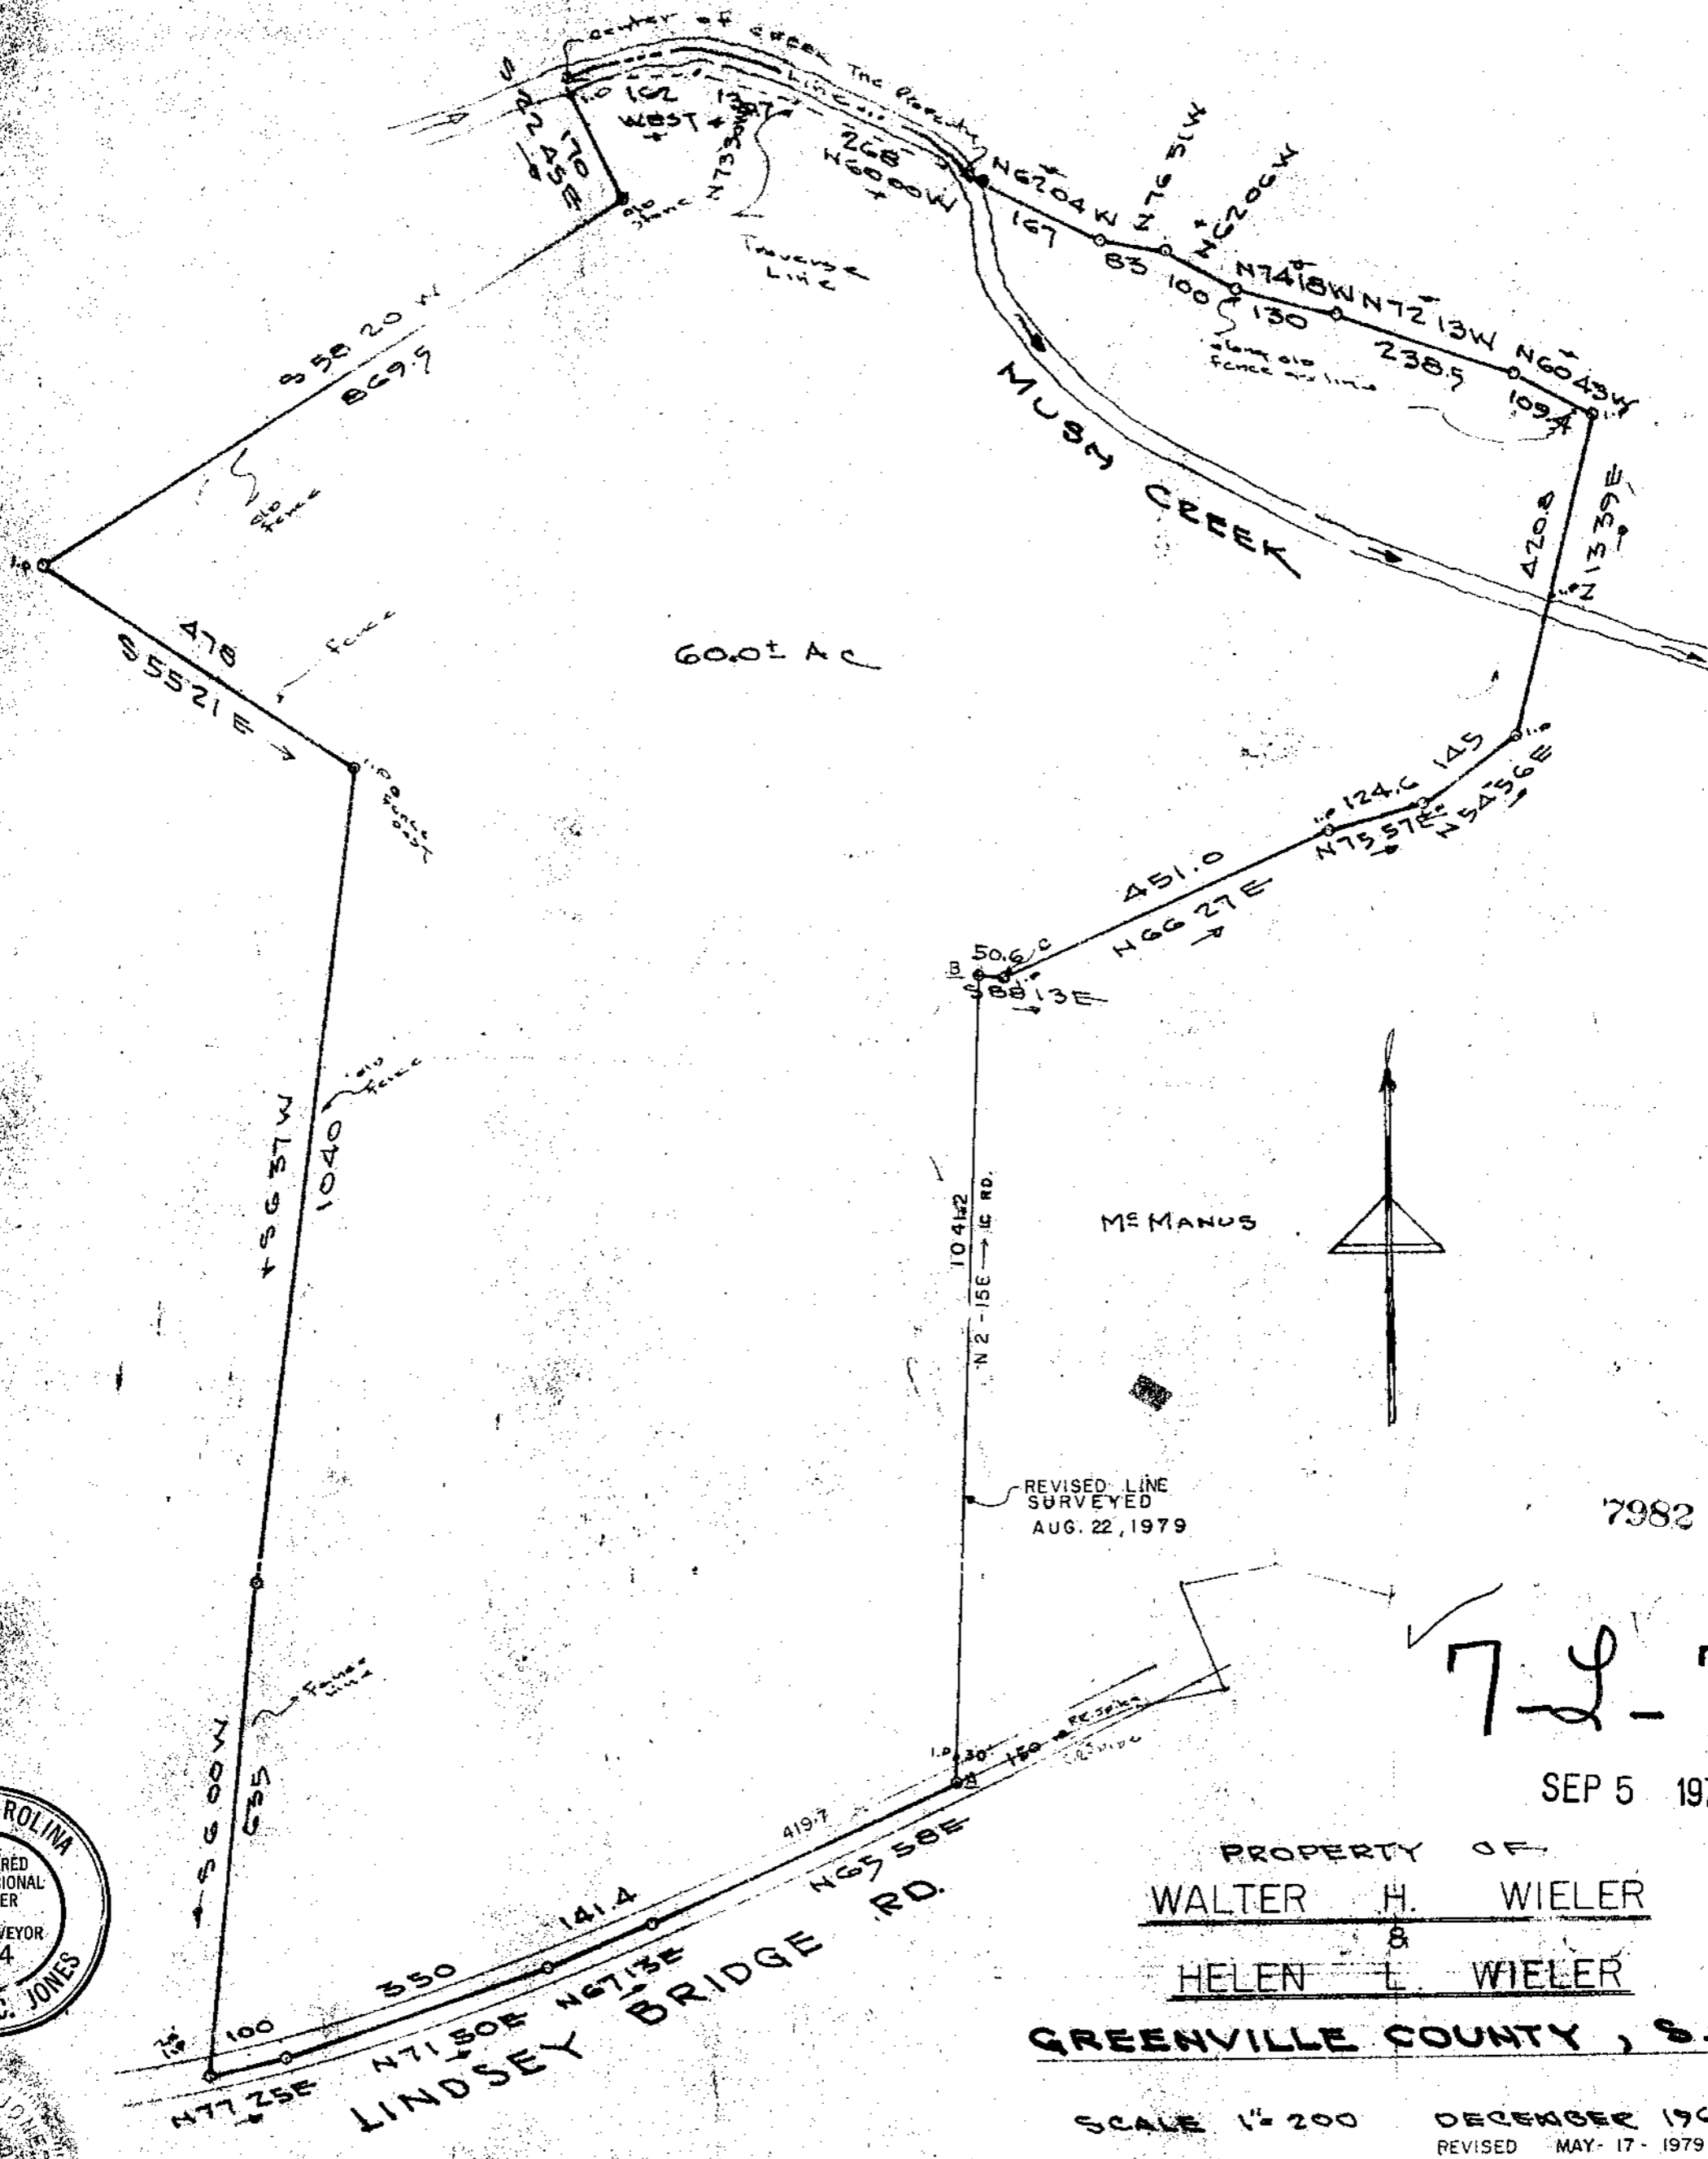

7-2-73

7982

SEP 5 1979

PROPERTY OF
WALTER H. WIELER
&
HELEN E. WIELER

GREENVILLE COUNTY, S.C.

SCALE 1" = 200

DECEMBER 1967
REVISED MAY-17-1979
FROM A-B-c

JONES ENGINEERING SERVICES GREENVILLE S.C.

