


MICROFILMED


FILED
GREENVILLE CO. S. C.
AUG 21 10 08 AM '79
DONNIE S. TANKERSLEY
R.M.C.

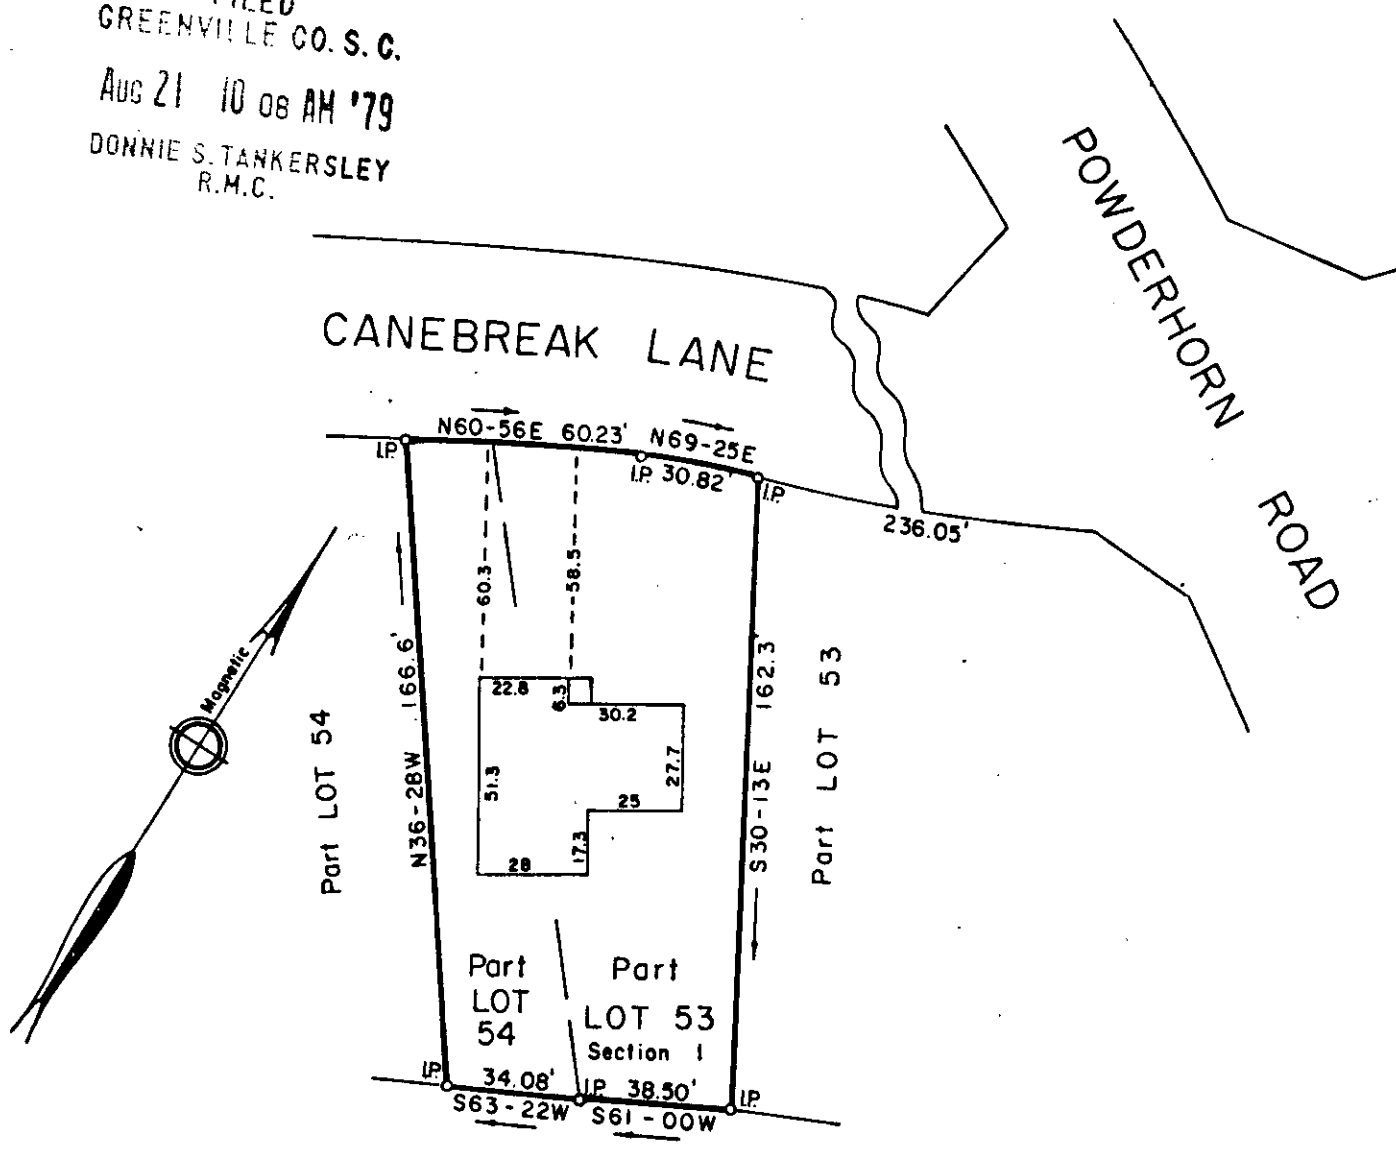

PROPERTY OF
DAVID O. ANDERSON, JR.
GREENVILLE CO., S.C.

Scale 1" = 50' August, 1979

This is to certify that on the 17th day of August, 1979, We surveyed the property shown on this plat; being known as Part Lot 54 and Part Lot 53 Section 1 on plat of Powderhorn, Recorded in Plat Book 4X page 95, Office of R. M. C. Greenville Co., S. C.; and that the property lines, walls and buildings are as shown hereon; that the buildings located on said lot do not encroach or project on adjacent streets or property; and that no adjacent buildings or walls encroach or project on said premises; and from information from Greenville County, this structure is not in a designated flood area.

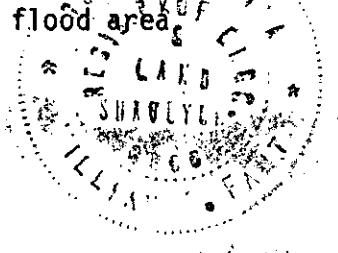

William B. Fento
Dalton & Neves Co., Engineers

7-M-75
AUG 21 1979
6192

6279 - 1 AUG 21 79 812