


MICROFILMED

KENMORE DR.
WATER & SEWER IN ST. R/W.

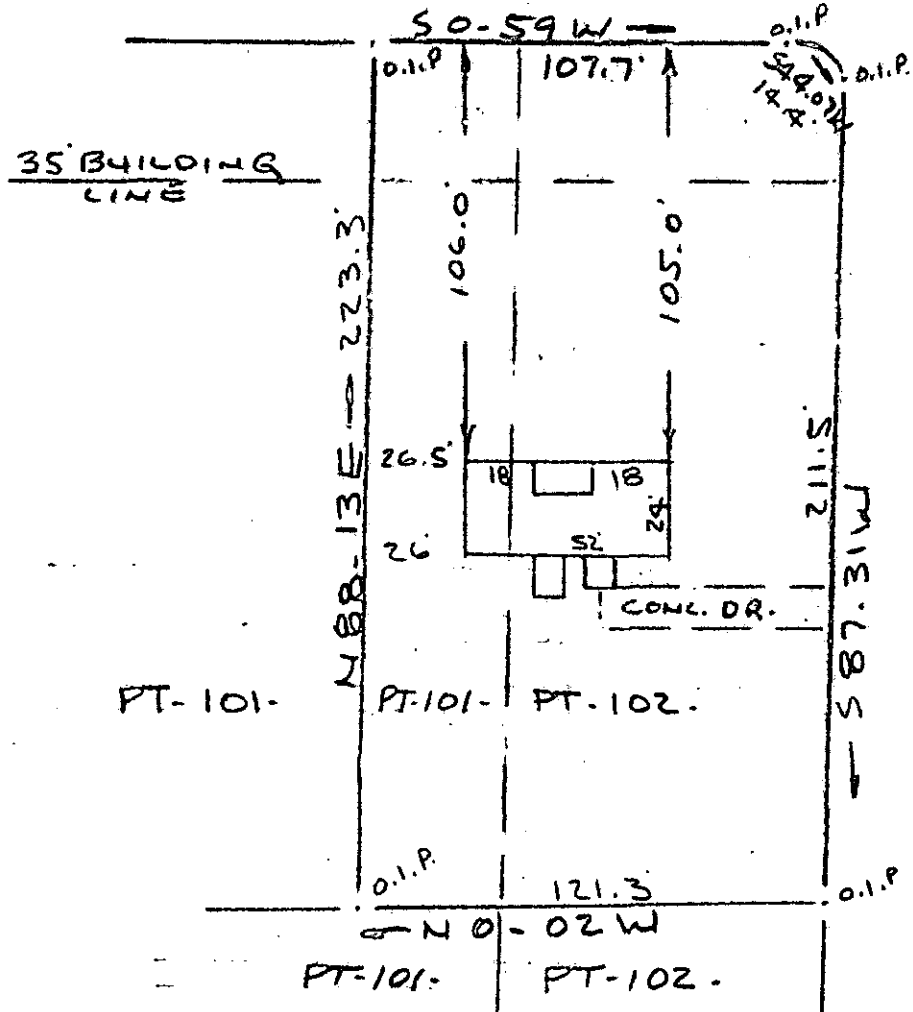

DUMONT AVENUE

FILED
GREENVILLE CO.
AUG 31 12 11 PM '79
DONNIE S. TANKERSLEY
R.M.C.

NOTE: Improvements on this lot are not in a flood hazard area.

7583

PROPERTY OF **GWENDOLYN JACKSON** **7-7-11**
NEAR GREENVILLE, S.C. **AUG 31 1979**
SCALE 1" = 50 **30 AUG 1979**

This is to certify that on the 30th day of August, 1979, I surveyed the property shown on this plat, being known as part of lot 101 and part of lot 102 on plat of ROCKVALE SUBDIVISION and recorded in the RMC Office Greenville County, S. C., in Plat Book "QQ" at Pages 108 & 109 and also being known as PROPERTY OF GWENDOLYN JACKSON and recorded in Plat Book at Page ; and that the property lines, walls and buildings are as shown hereon, and that the walls and buildings located on said lot do not encroach or project on adjacent street or property, and that no adjacent walls or buildings encroach or project on said premises, and no power lines cross this property except as shown hereon.

R. B. Bruce
R. B. Bruce, RLS #1952

CAROLINA SURVEYING CO.
113 Manly St. 79
Greenville, S.C. 861

217@10

WG 6.2-1-144