AF 10505

MICROFILMED

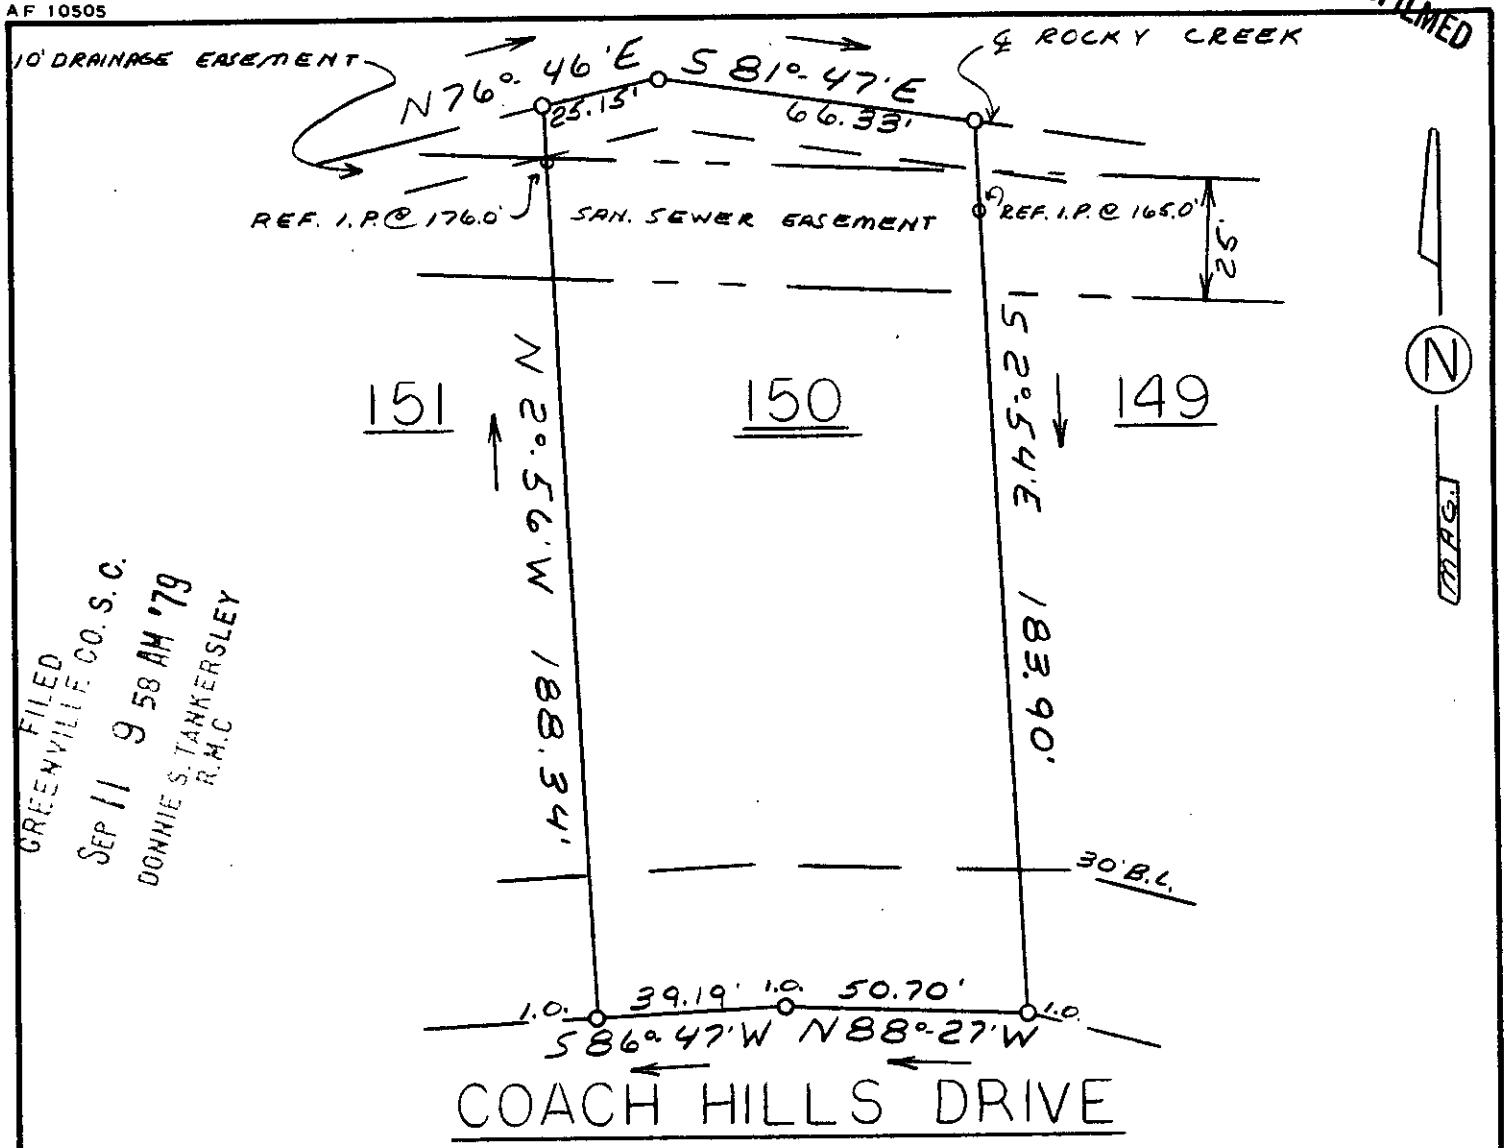

FILED
GREENVILLE CO. S.C.
SEP 11 9 58 AM '79
DONNIE S. TANKERSLEY
R.H.C

This is to certify that on September 7, 1979, I surveyed the property shown on this plat, known as Lot 150 on plat of Coach Hills, recorded in the RMC Office of Greenville County in Plat Book 4X on pages 85 and 86, and that the property lines, walls and buildings are as shown hereon; that no adjacent walls or buildings encroach or project on said premises, and that no utility lines cross this property except as shown hereon. This property is not located in a designated flood hazard area.

5' drainage and utility easement each side of all side and rear loy lines.

8570 ✓ 7N-37

40 0 40 80
scale feet

James R. Freeland RLS & PE 4781

SOUTH CAROLINA REGISTERED LAND SURVEYOR NO. 4781 JAMES RALPH FREELAND

SEAL

STATE OF SOUTH CAROLINA
GREENVILLE COUNTY

COACH HILLS
LOT 150
PROPERTY OF
JEFFREY C.M. LI
&
LILYAN K. LI

FREELAND & ASSOCIATES
Engineers • Land Surveyors
GREENVILLE, S.C.

SURVEY	JRF
DRAWN	M.C.
CHECK	M.C.
SCALE	1" = 40'
DATE	9-7-79
DWG. NO.	79-4016