


MICROFILMED

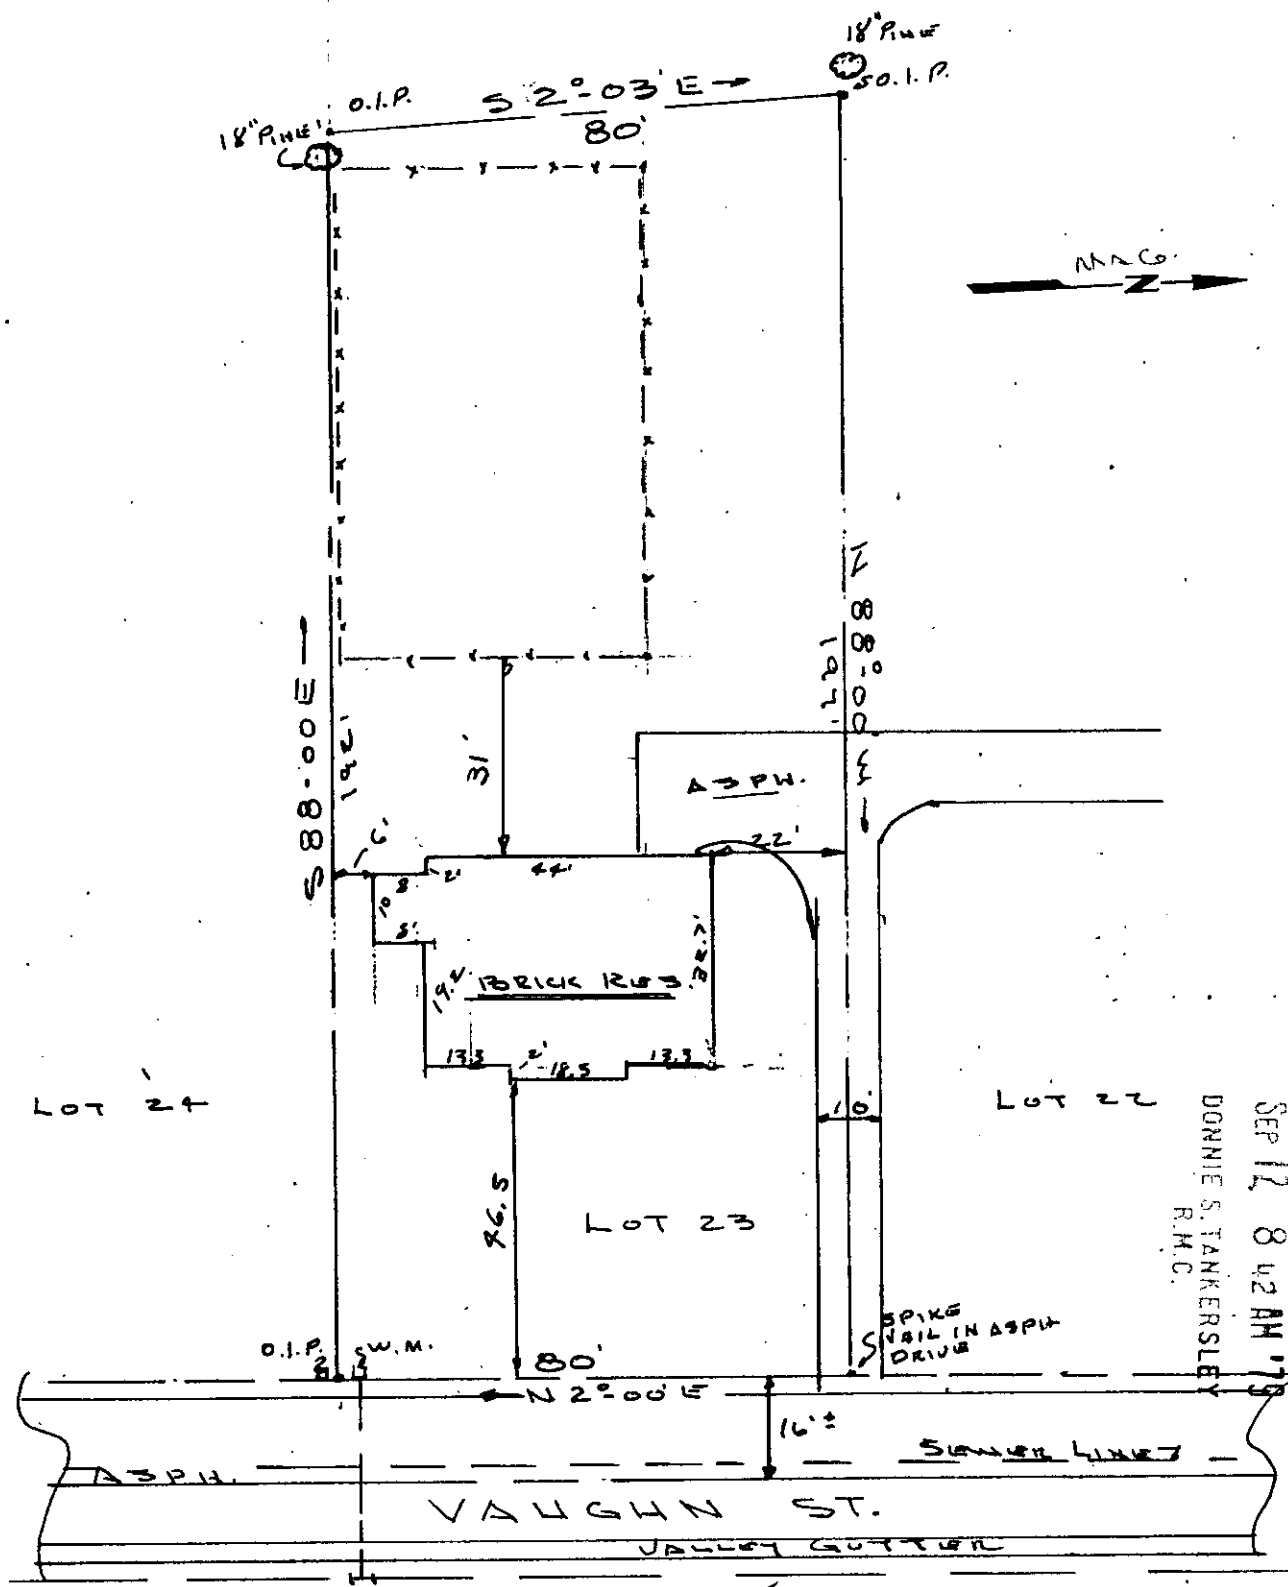

LOT 21

LOT 22

LOT 23

FILED
 GREENVILLE CO. S. C.
 SEP 12 8 42 AM '79
 DONNIE S. TANKERSLEY
 R.M.C.


GCTO 3 1907

P.L.T. BK. 17 P. 365
 PLK BK. G-18-3-35
 1907 VOL. 994 P. 680
 WICK SPRINGS TOWNSHIP
 GREENVILLE CO.
 GREEN S.C.

N-42 8751

I CERTIFY THE ABOVE TRACT HAS BEEN RE-SURVEYED AND IS AS SHOWN.

Kenneth T. Gould
 S.C. REG. NO 4035

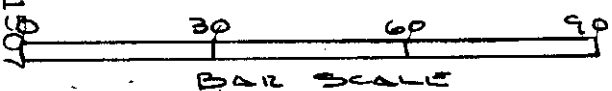

Seal 3.0001 9-12-1979	PROPERTY OF MCELRATH & TUCKER INC PLEASANT VIEW ACRES		Drawn By K.T.G.
			Checked By
			Scale 1" = 30'
			Date 6-6-79
			File No.
GOULD & ASSOC SURVEYORS TAYLORS, S. C.		Dwg. No.	