


MICROFILMED

PARIS MOUNTAIN RD.
WATER & SEWER IN ST. R/W

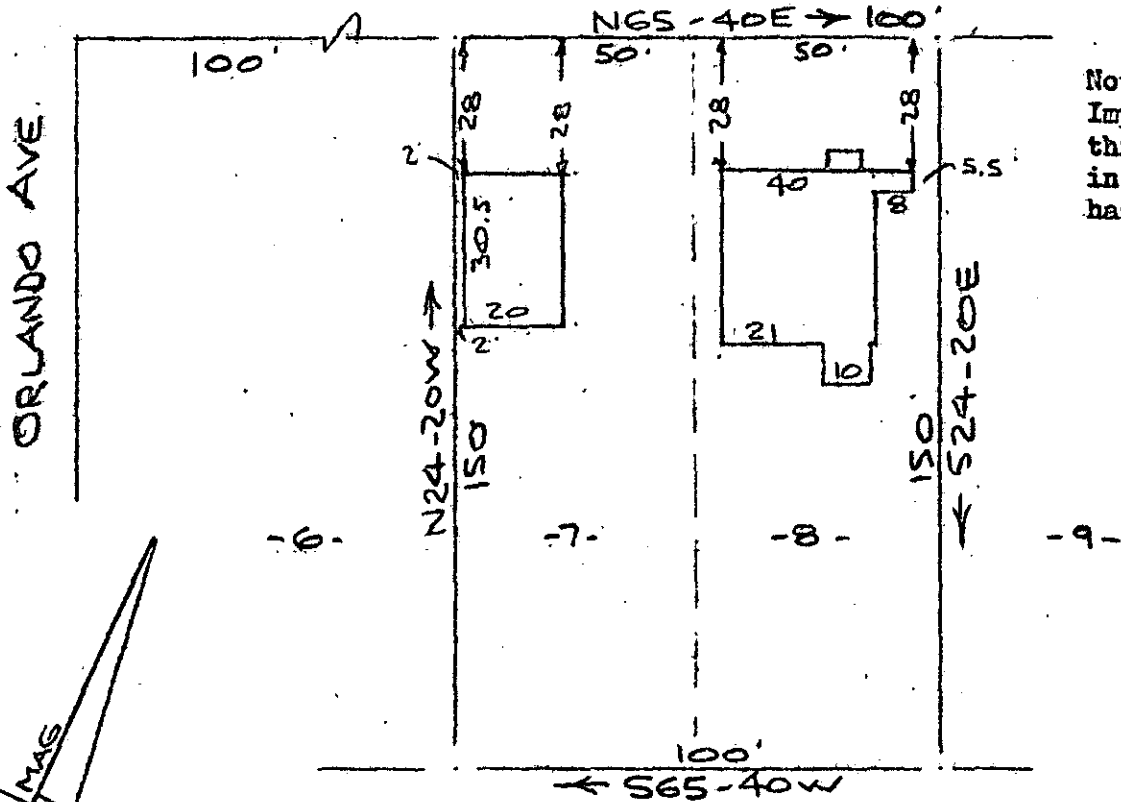

Note:
Improvements on
this lot are not
in a flood
hazard area.

FILED
GREENVILLE CO. S. C.
SEP 17 12 18 PM '79
DONNIE S. TANKERSLEY
R.M.C.

PROPERTY OF
WILLIAM A. NARAGON & PHYLLIS J. NARAGON
NEAR GREENVILLE, S. C.
SCALE: 1" = 40' 11 SEPT 1979

This is to certify that on the 11th day of September, 1979, I surveyed the property shown on this plat, being known as lots 7 & 8 on plat of PARRIS-FINEY PARK and recorded in the RMC Office Greenville County, S. C., in Plat Book " H " at Page 19; and that the property lines, walls and buildings are as shown hereon, and that the walls and buildings located on said lot do not encroach or project on adjacent street or property, and that no adjacent walls or buildings encroach or project on said premises, and no power lines cross this property except as shown hereon.

9283

7-N-61

R. B. Bruce

R. B. Bruce, HLS #1952

SEP 17 1979

CAROLINA SURVEYING CO.
112 Manly St.
Greenville, S. 8 3 10 TP 17E

3.00 A4