
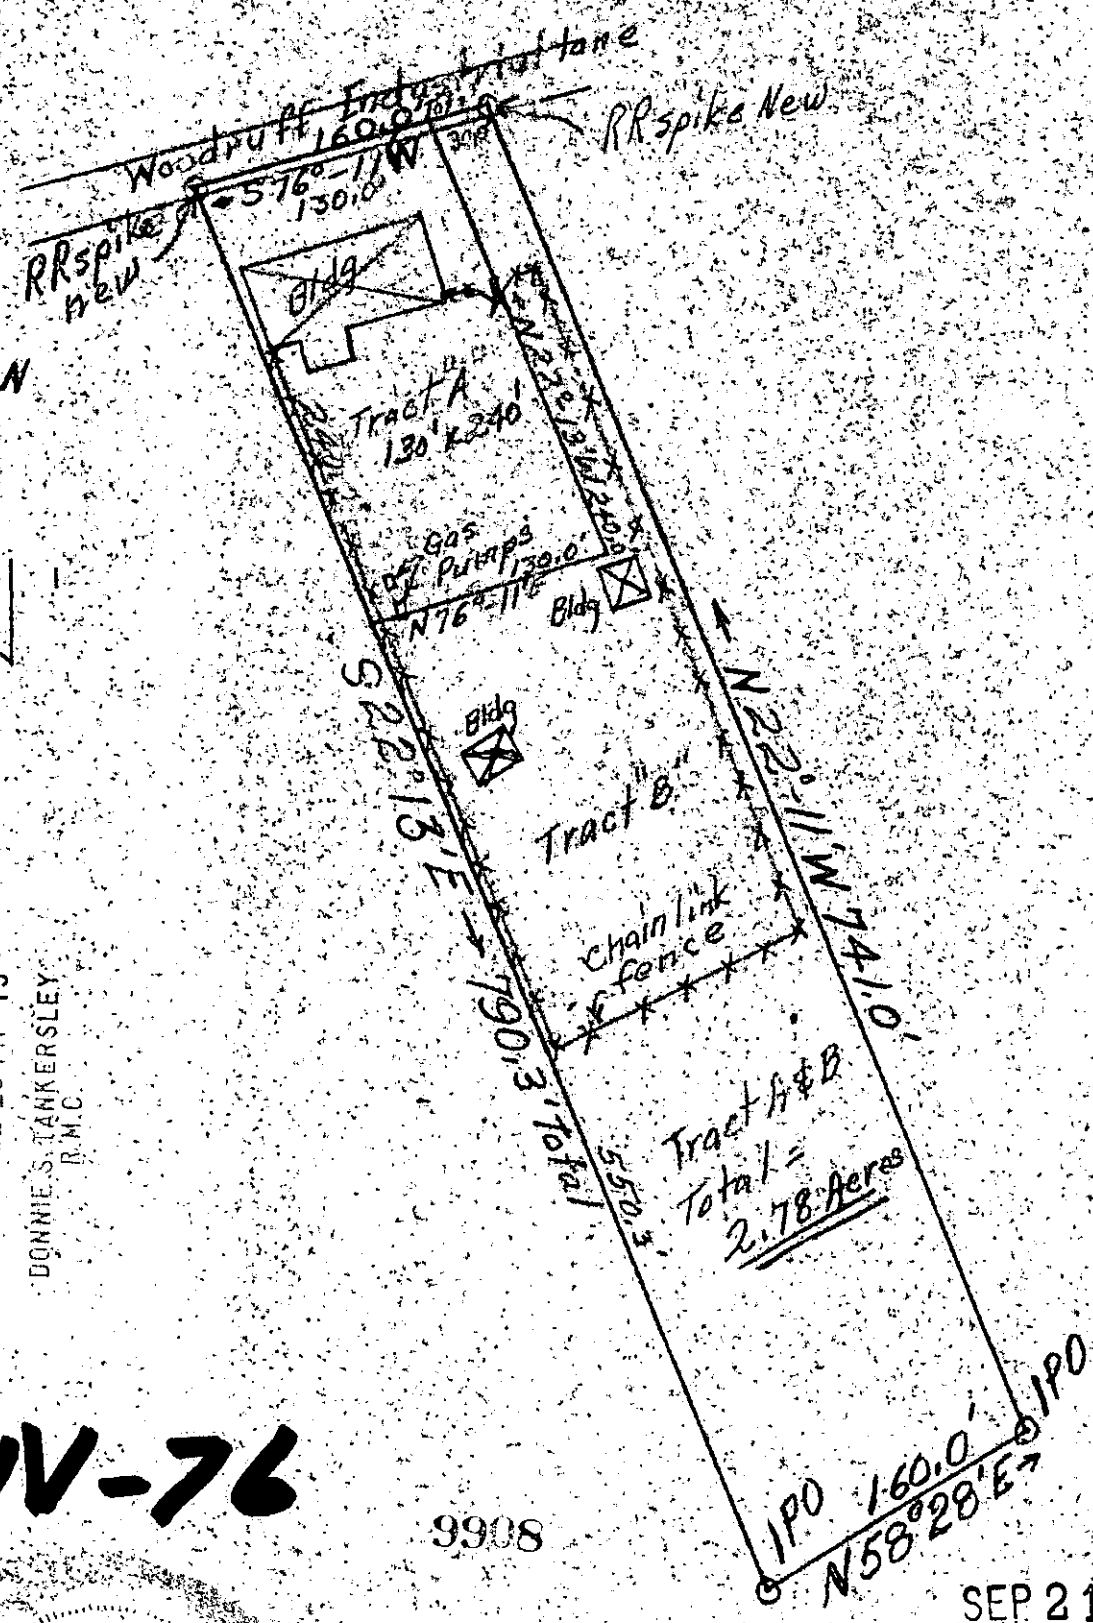


MICROFILMED

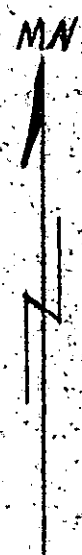

FILED
 GREENVILLE CO. S.C.
 SEP 21 12 18 PM '79
 DONNIE S. TANKERSLEY
 R.M.C.

7-IV-76

9908

SEP 21 1979



THIS IS TO CERTIFY THAT ON JUNE 11, 1979 I SURVEYED THE LOTS SHOWN FOR RANDOM ASSOCIATES (DANIEL R. BOLING & CARL L. WHALEY) AND ALL LINES AND BUILDINGS ARE AS SHOWN AND THERE IS NO ENCROACHMENT ON SAID LINES, LOCATED IN GREENVILLE COUNTY, S.C. APPROXIMATELY 3 MILES SOUTH OF GREENVILLE, S.C. SCALE 1"=100'

Alex. D. Moss REG. C. E. & L. S. # 1194 SEP 21 1979 255 30001