


FILED
 GREENVILLE CO., S.C.
 DEC 28 10 11 AM '79
 DONNIE S. TANKERSLEY
 R.M.C.

Note: Improvements on this lot are not in a flood hazard area.

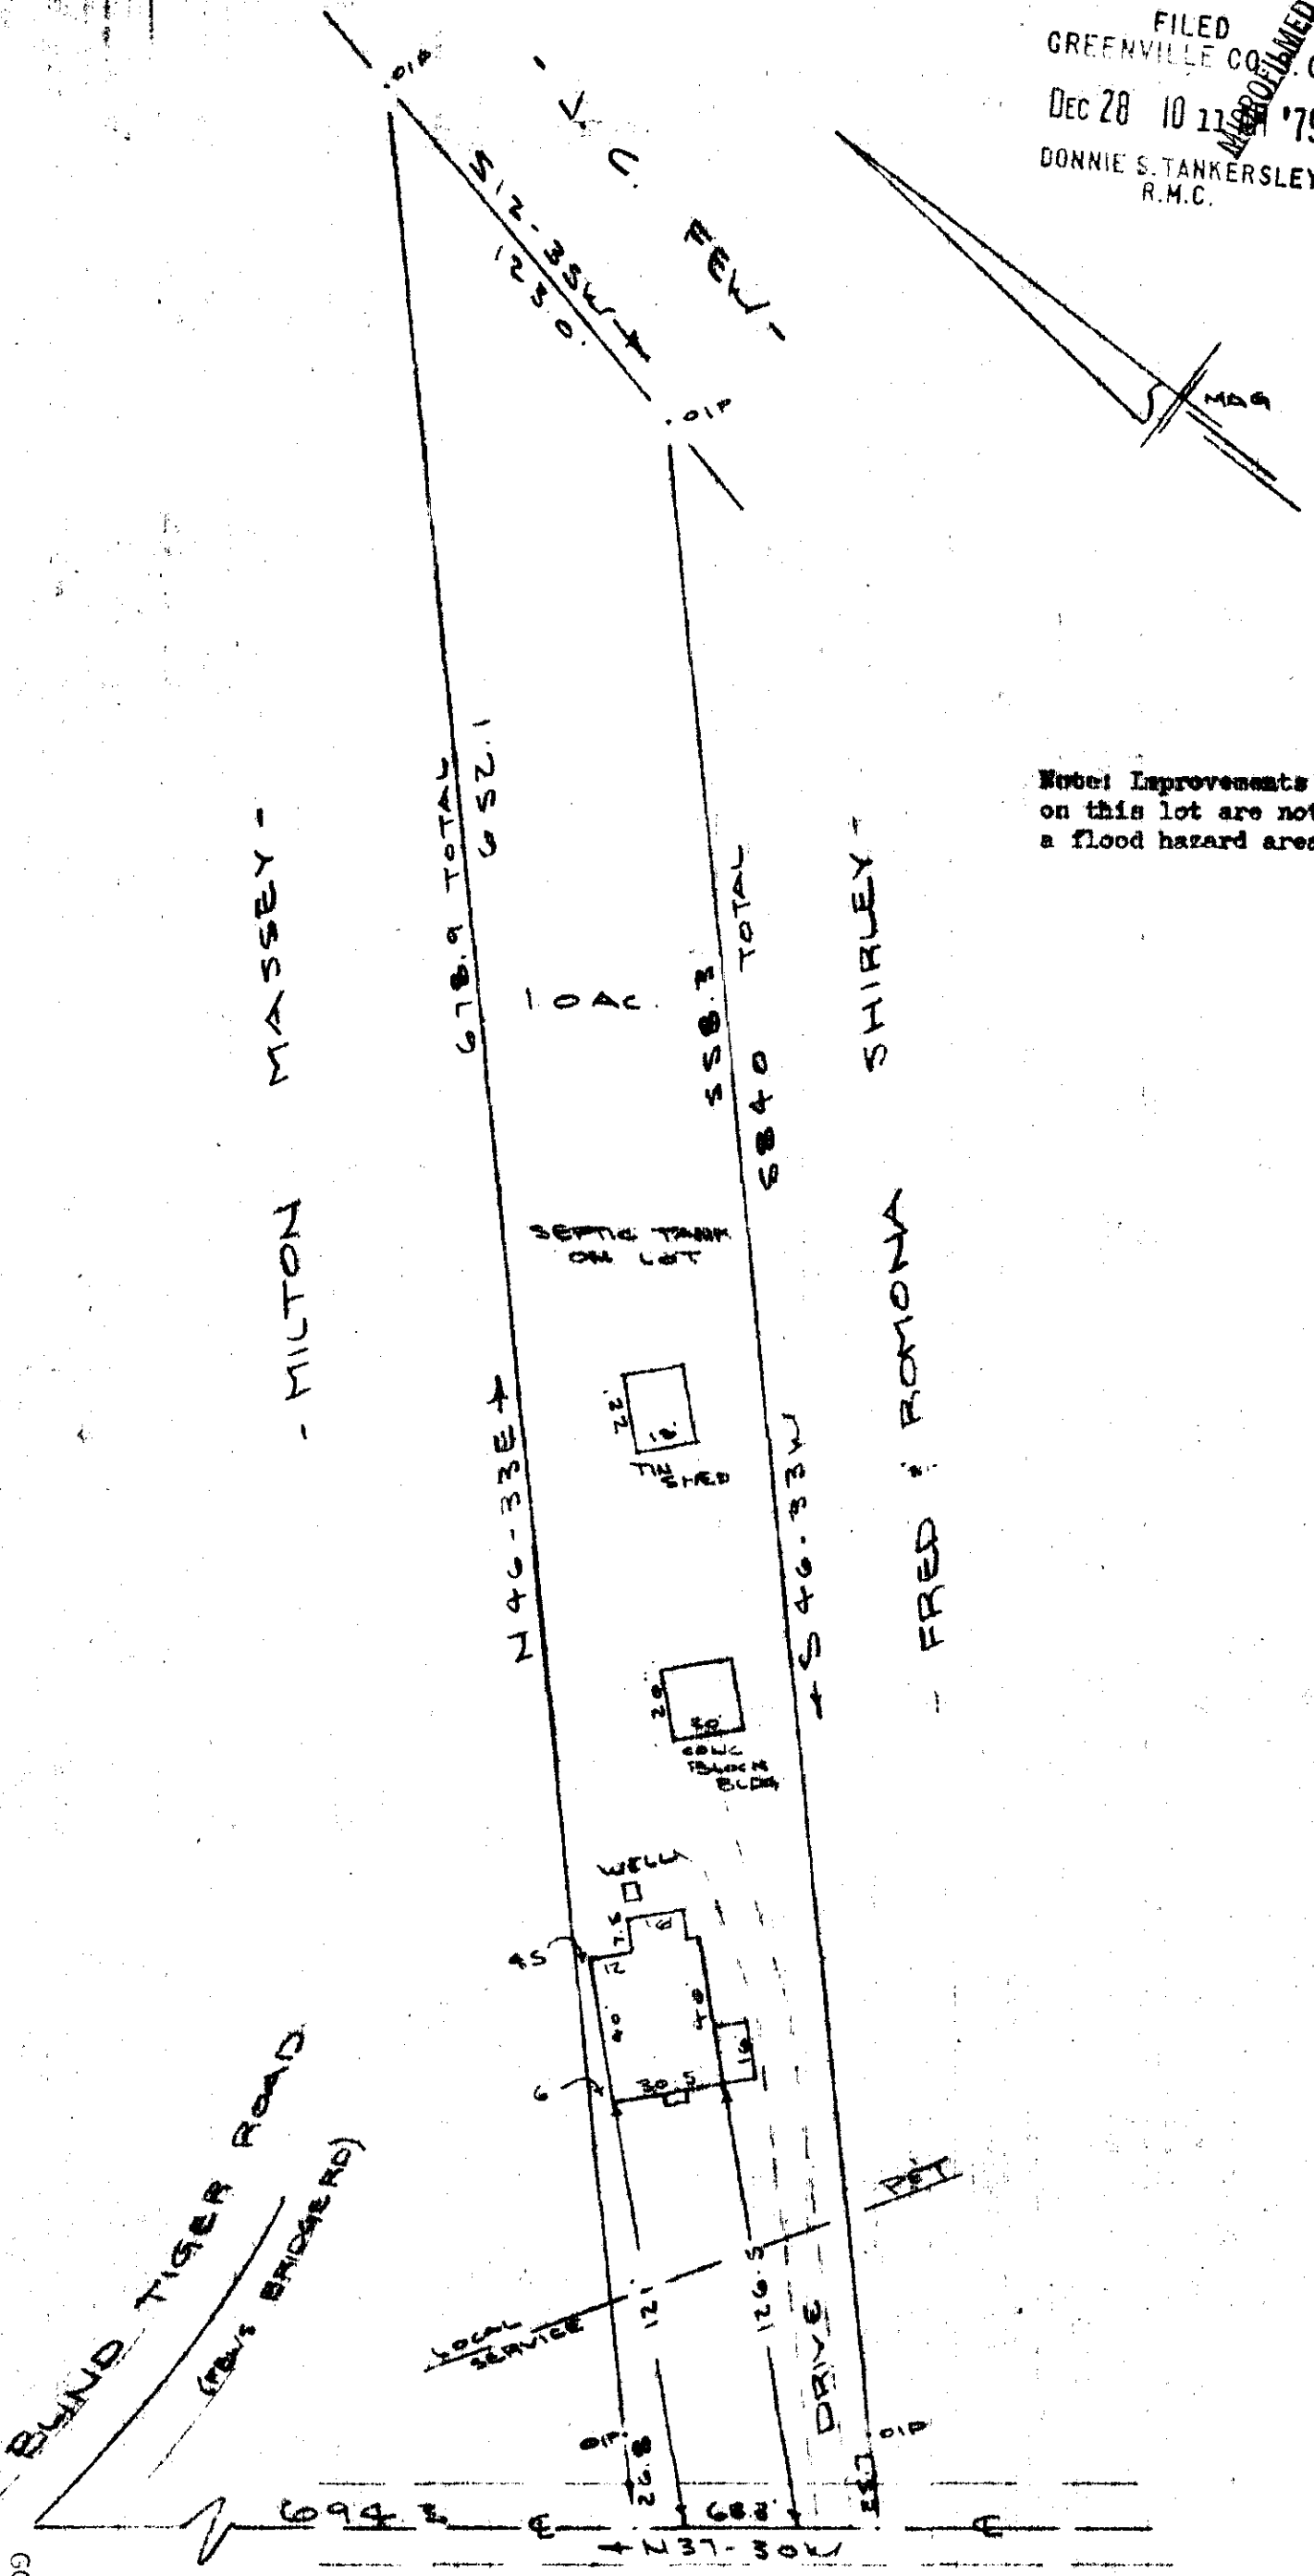

PROPERTY OF
 JOE HAROLD CAMPBELL & MARY B. CAMPBELL
 NEAR GREENVILLE, S.C.
 SCALE 1" = 30'

DEC 24 1979

This is to certify that on the 24th day of December, 1979, I surveyed the property shown on this plat, being known as PROPERTY OF JOE HAROLD CAMPBELL & MARY B. CAMPBELL and recorded in Plat Book at Page ; and that the property lines, walls and buildings are as shown hereon, and that the walls and buildings located on said lot do not encroach or project on adjacent street or property, and that no adjacent walls or buildings encroach or project on said premises, and no power lines cross this property except as shown hereon.

DEC 28 1979

7-0-63

20697

R. B. Bruce

R. B. Bruce, RLS #1952

5.0001

CAROLINA SURVEYING CO.
 112 Manly St.
 Greenville, S.C.

59/57A

642.1-1-4