


FILED
GREENVILLE CO. S.C.
OCT 1 1 36 PM '79
DONN L. STANKERSLEY
R.M.C.

RECORDED

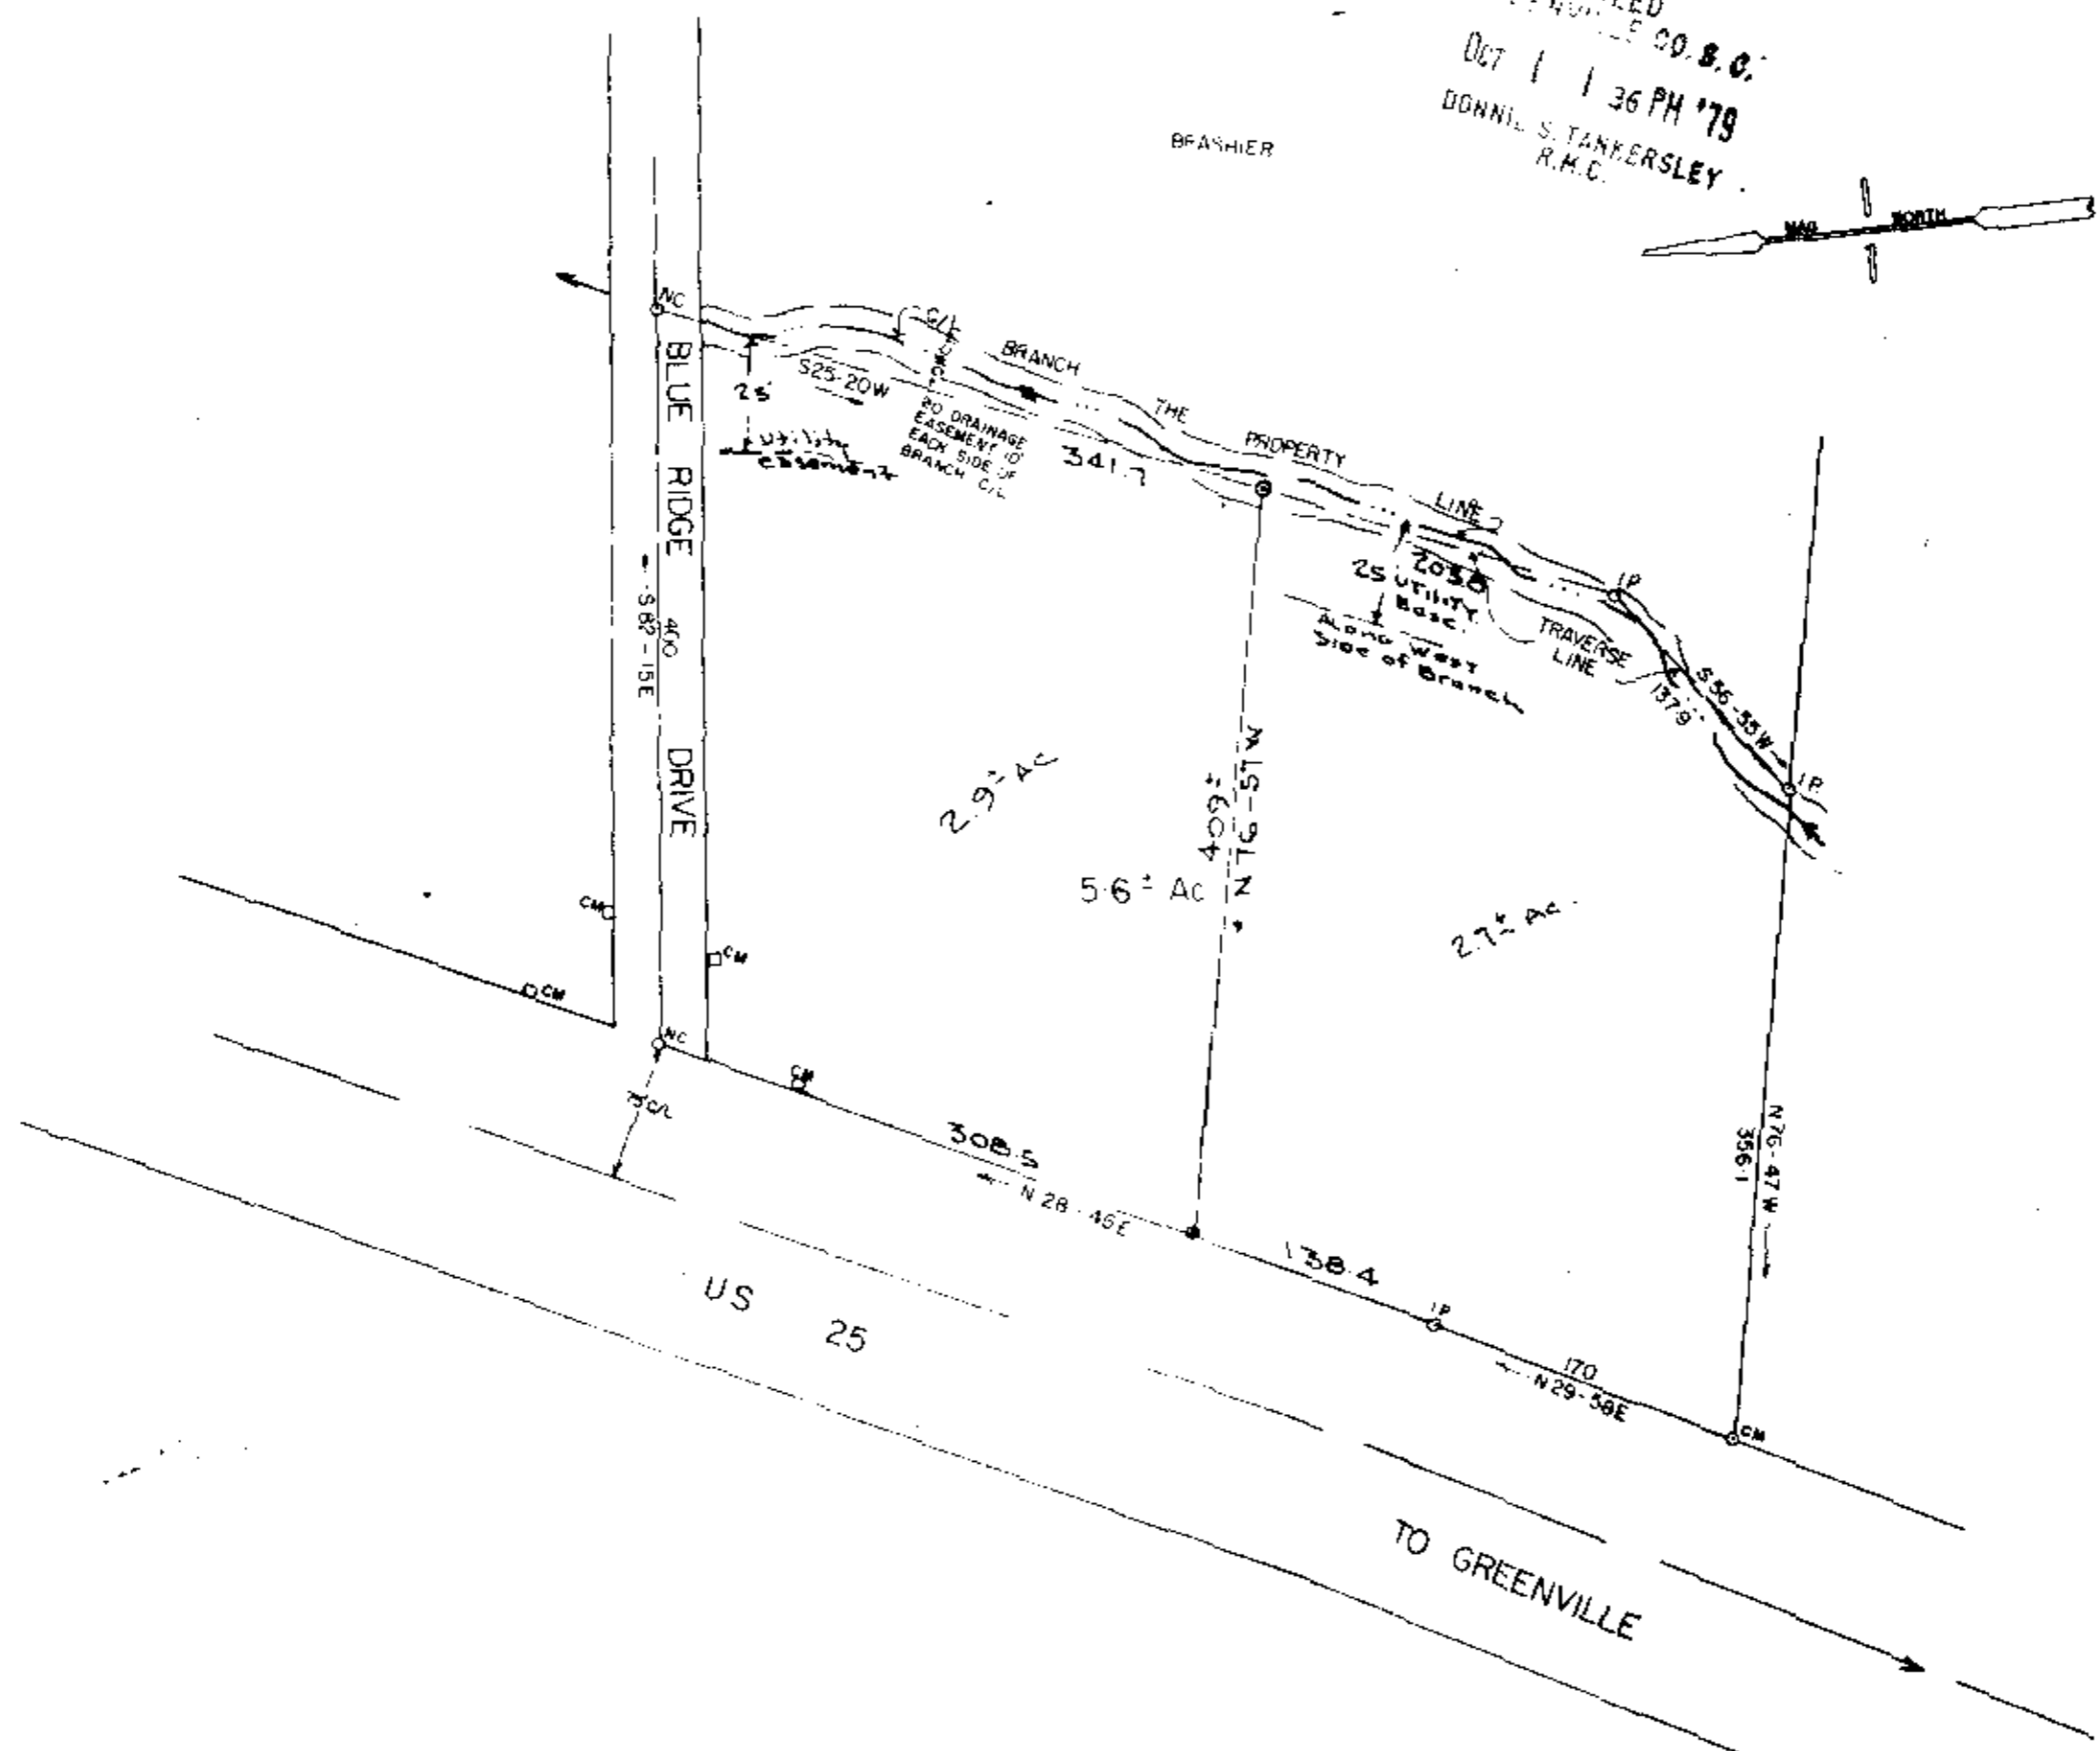

PROPERTY OF
T. WALTER BRASHIER 11051

GREENVILLE COUNTY, S.C.
SCALE 1"=100' SEPT-5-78
Revised SEPT 25 1979



70-9
see

OCT 1 1979